

WW-7  
8-30-06



West Virginia Department of Environmental Protection  
Office of Oil and Gas  
**WELL LOCATION FORM: GPS**

API: 47-039-04202 WELL NO.: Hively #1

FARM NAME: Hively

RESPONSIBLE PARTY NAME: Pillar Energy LLC

COUNTY: Kanawha DISTRICT: Big Sandy

QUADRANGLE: ~~Big Fork of Little Sandy Creek~~ KETTLE

SURFACE OWNER: Jerry Hively & Roberty Hively

ROYALTY OWNER: \_\_\_\_\_

UTM GPS NORTHING: 4262386.7

UTM GPS EASTING: 463556 GPS ELEVATION: 1063

The Responsible Party named above has chosen to submit GPS coordinates in lieu of preparing a new well location plat for a plugging permit or assigned API number on the above well. The Office of Oil and Gas will not accept GPS coordinates that do not meet the following requirements:

- Datum: NAD 1983, Zone: 17 North, Coordinate Units: meters, Altitude: height above mean sea level (MSL) – meters.
- Accuracy to Datum – 3.05 meters
- Data Collection Method:

Survey grade GPS \_\_\_\_\_: Post Processed Differential \_\_\_\_\_

Real-Time Differential \_\_\_\_\_

Mapping Grade GPS : Post Processed Differential \_\_\_\_\_

Real-Time Differential \_\_\_\_\_

- Letter size copy of the topography map showing the well location.**

I the undersigned, hereby certify this data is correct to the best of my knowledge and belief and shows all the information required by law and the regulations issued and prescribed by the Office of Oil and Gas.


[Signature]  
Signature

CEO  
Title


3-30-23  
Date

RECEIVED  
Office of Oil and Gas  
APR 13 2023  
WV Department of  
Environmental Protection

# Hively #1

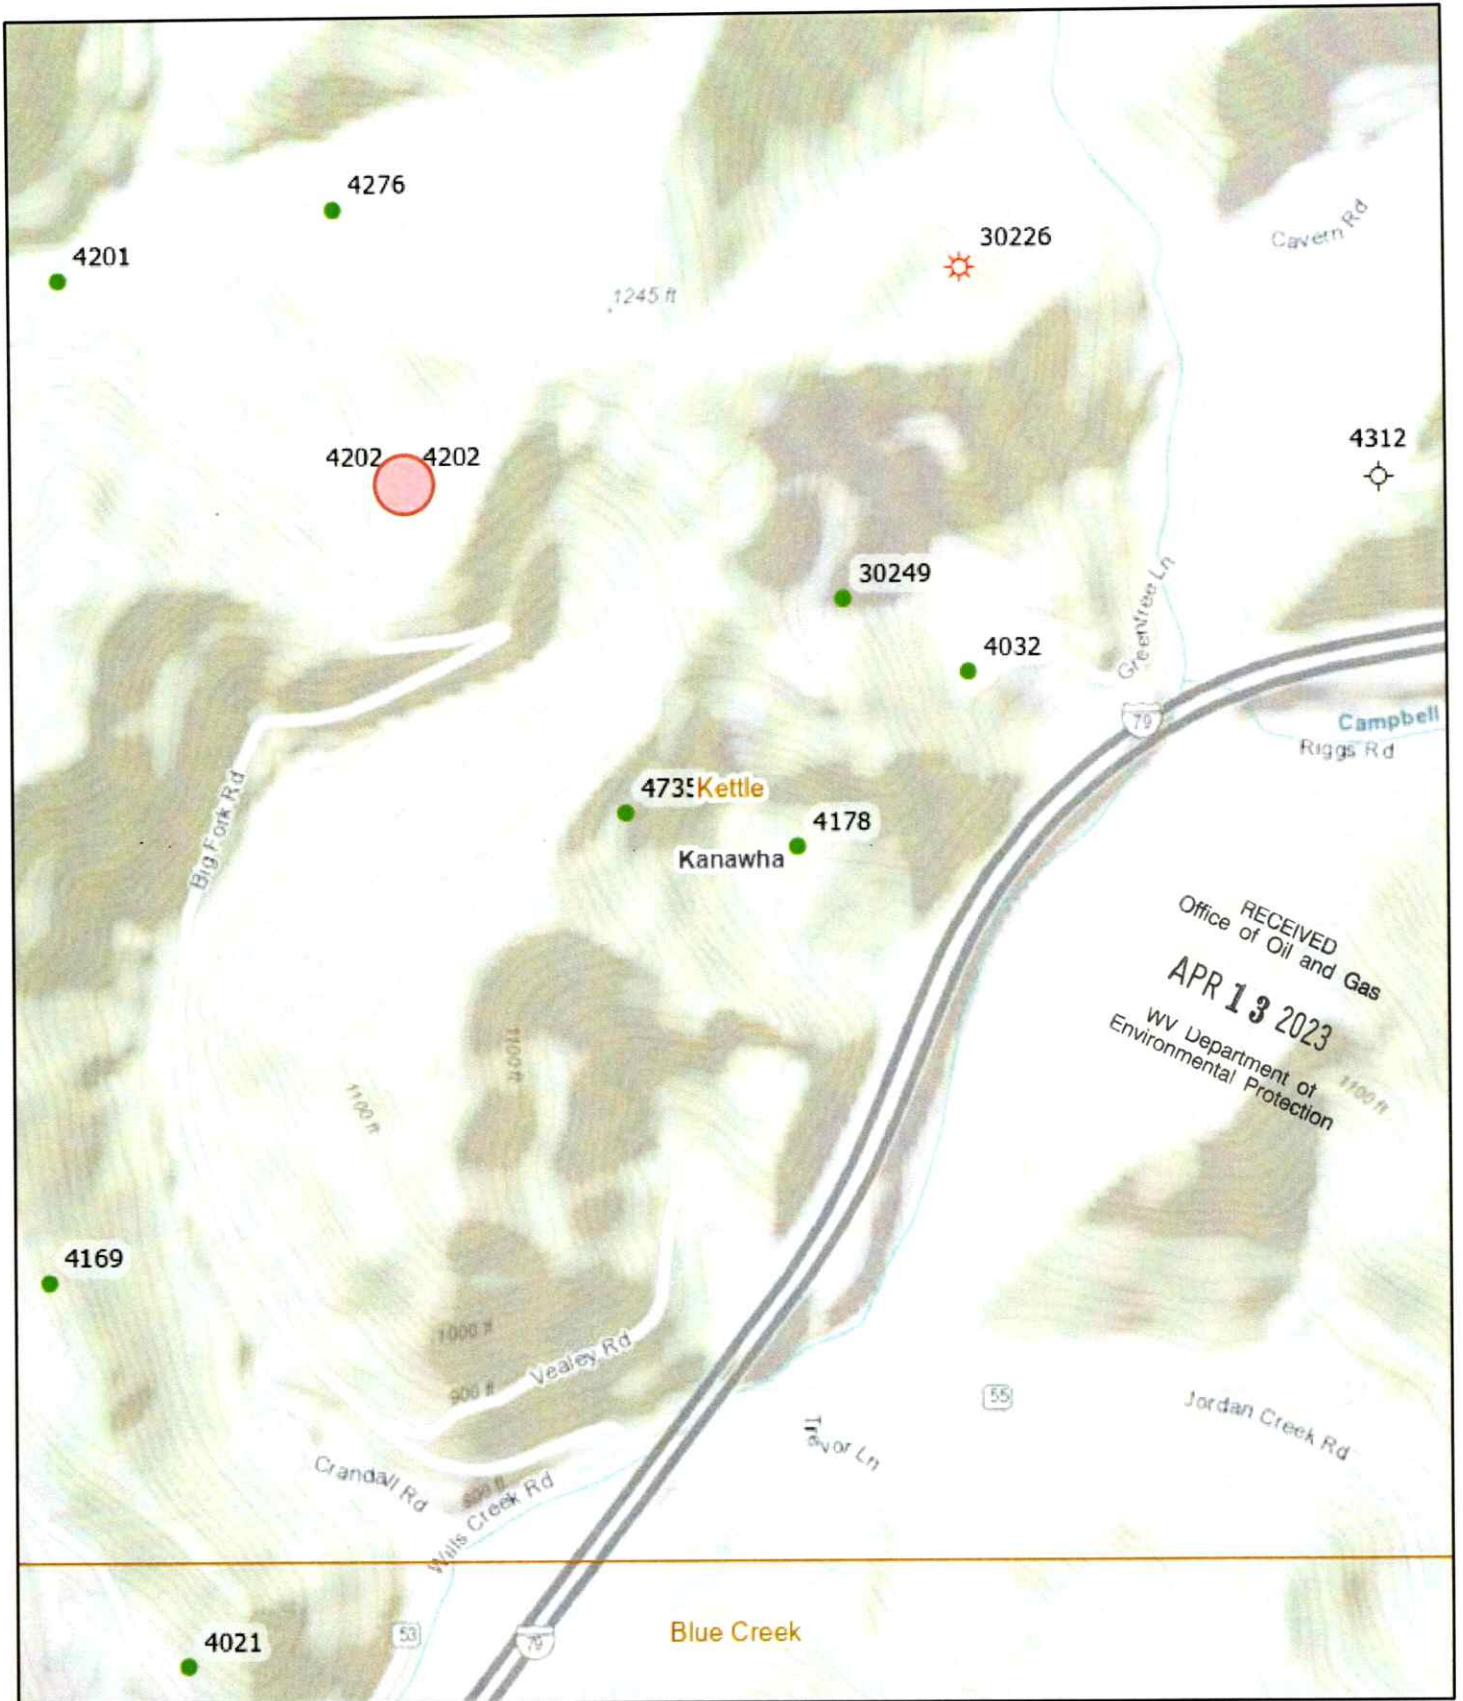

3/30/2023, 10:58:23 AM

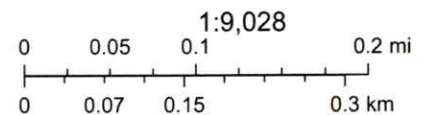

- |                           |                                     |
|---------------------------|-------------------------------------|
| Labels (7.5' Quadrangles) | WV Oil and Gas All Individual Wells |
| 7.5' Quadrangles          | Gas                                 |
| State Boundary            | Oil                                 |
| Counties                  | Combination Oil & Gas               |

05/11/2023