


Well Location Map for  
47-039-04457  
Dickinson #50

Northing: 4235141.654  
Easting: 475317.782  
Elevation: 1284 ft

UTM NAD83 Zone 17N Meters


GREYLOCK  
Greylock Conventional, LLC  
500 Corporate Landing  
Charleston, WV 25311

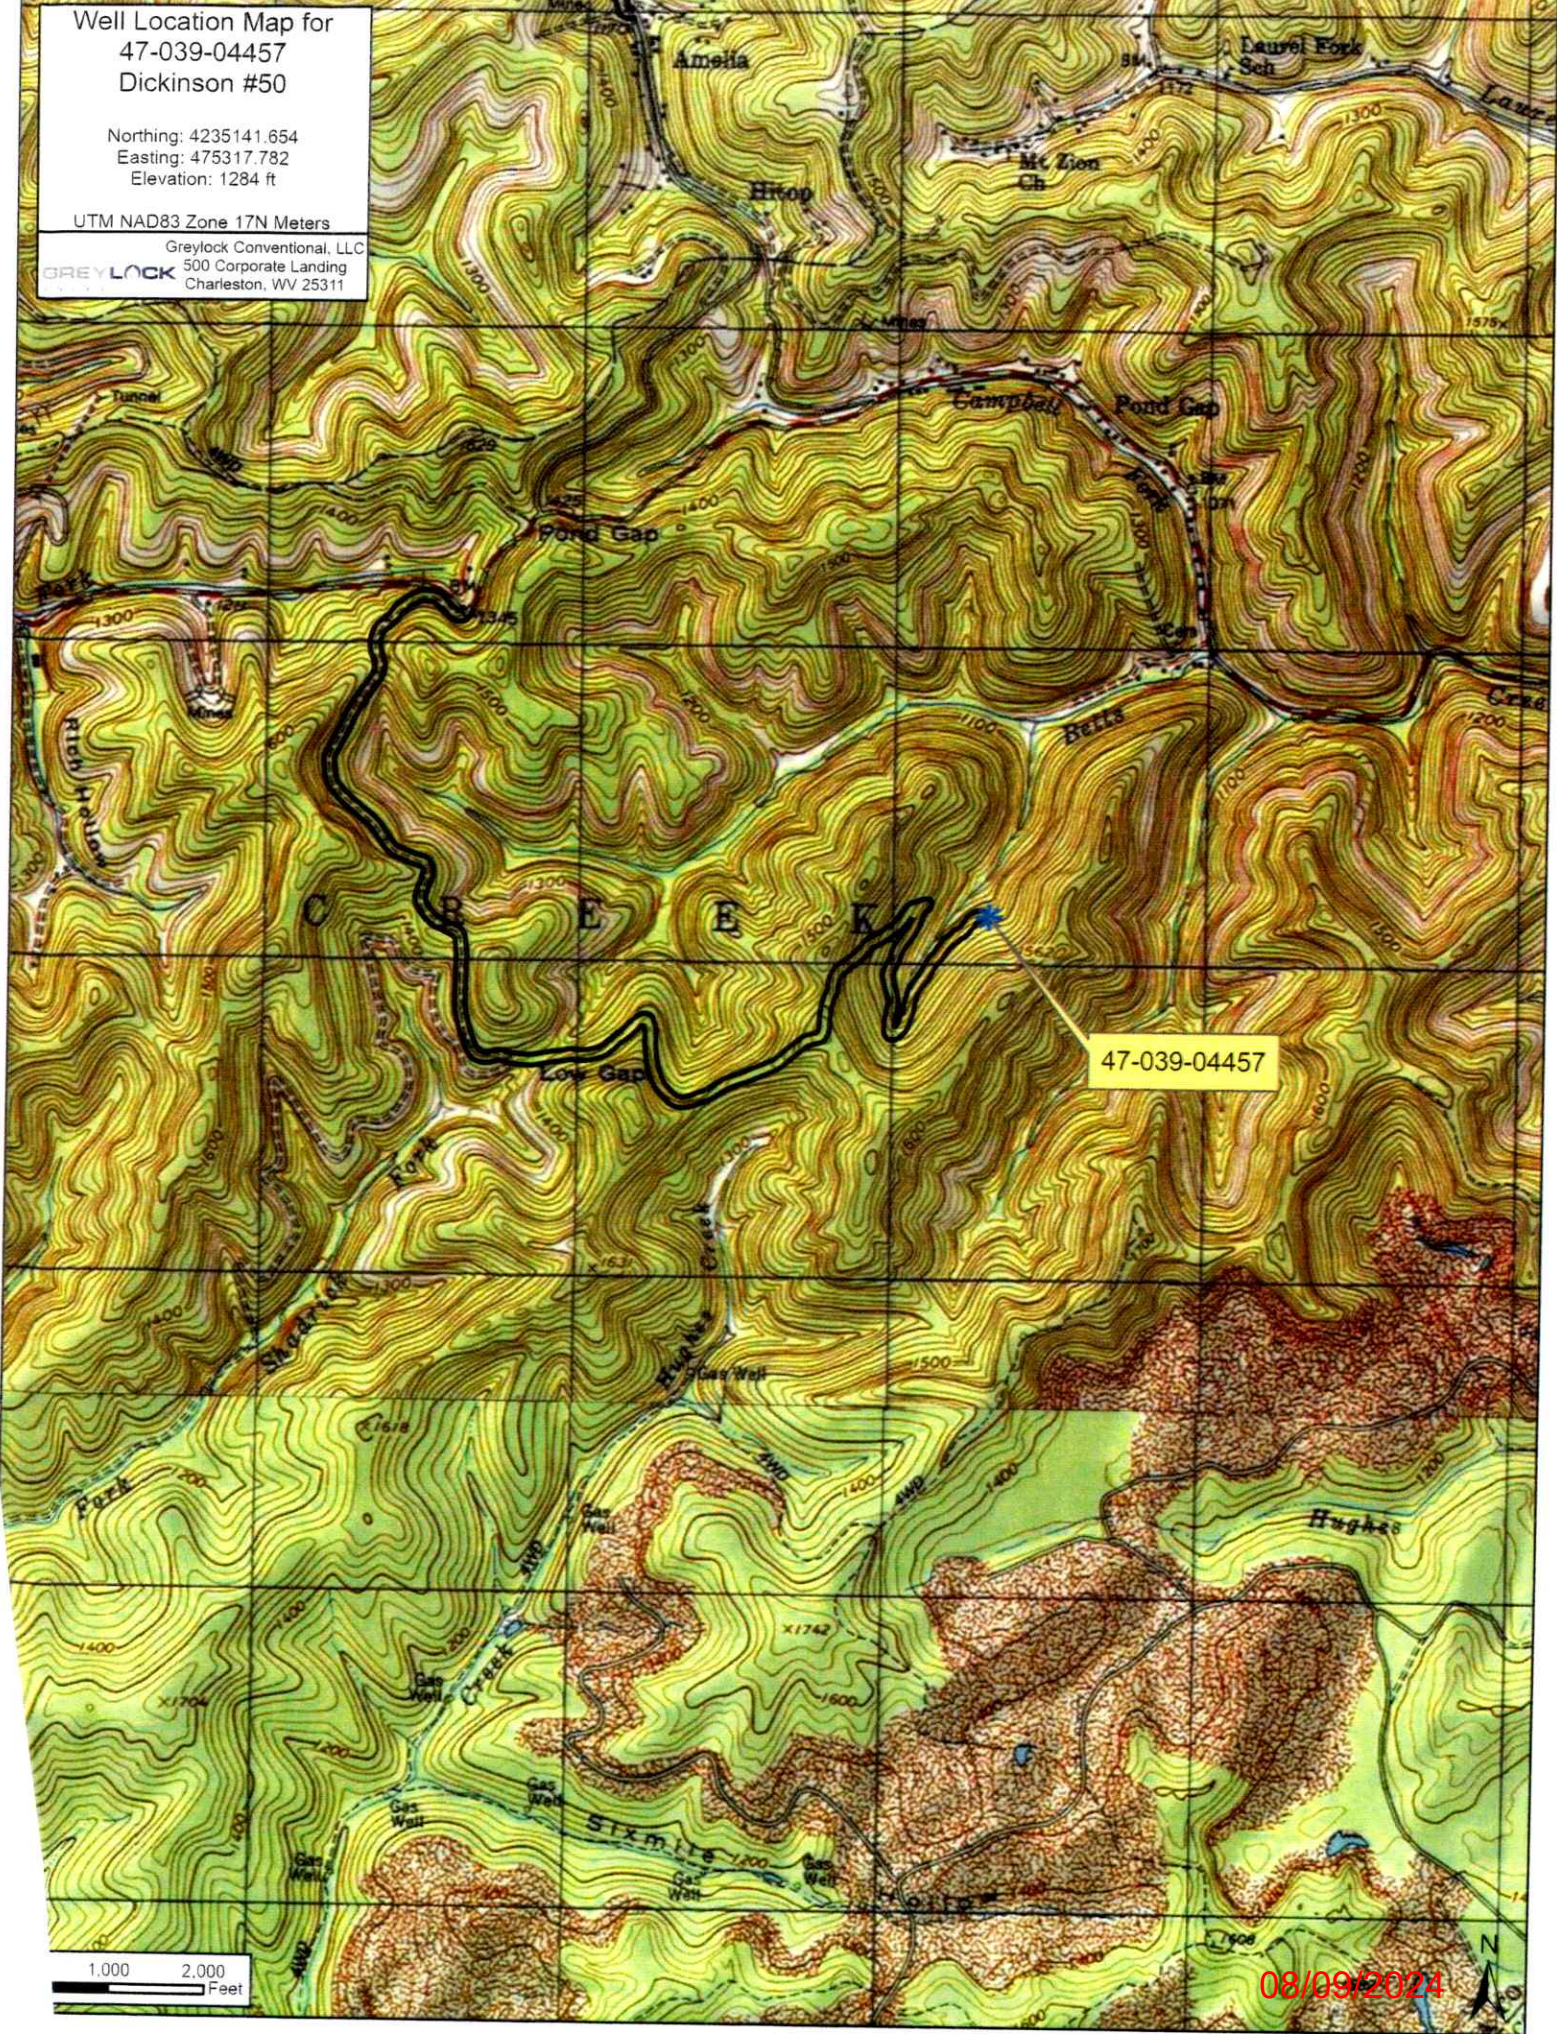

47-039-04457

08/09/2024



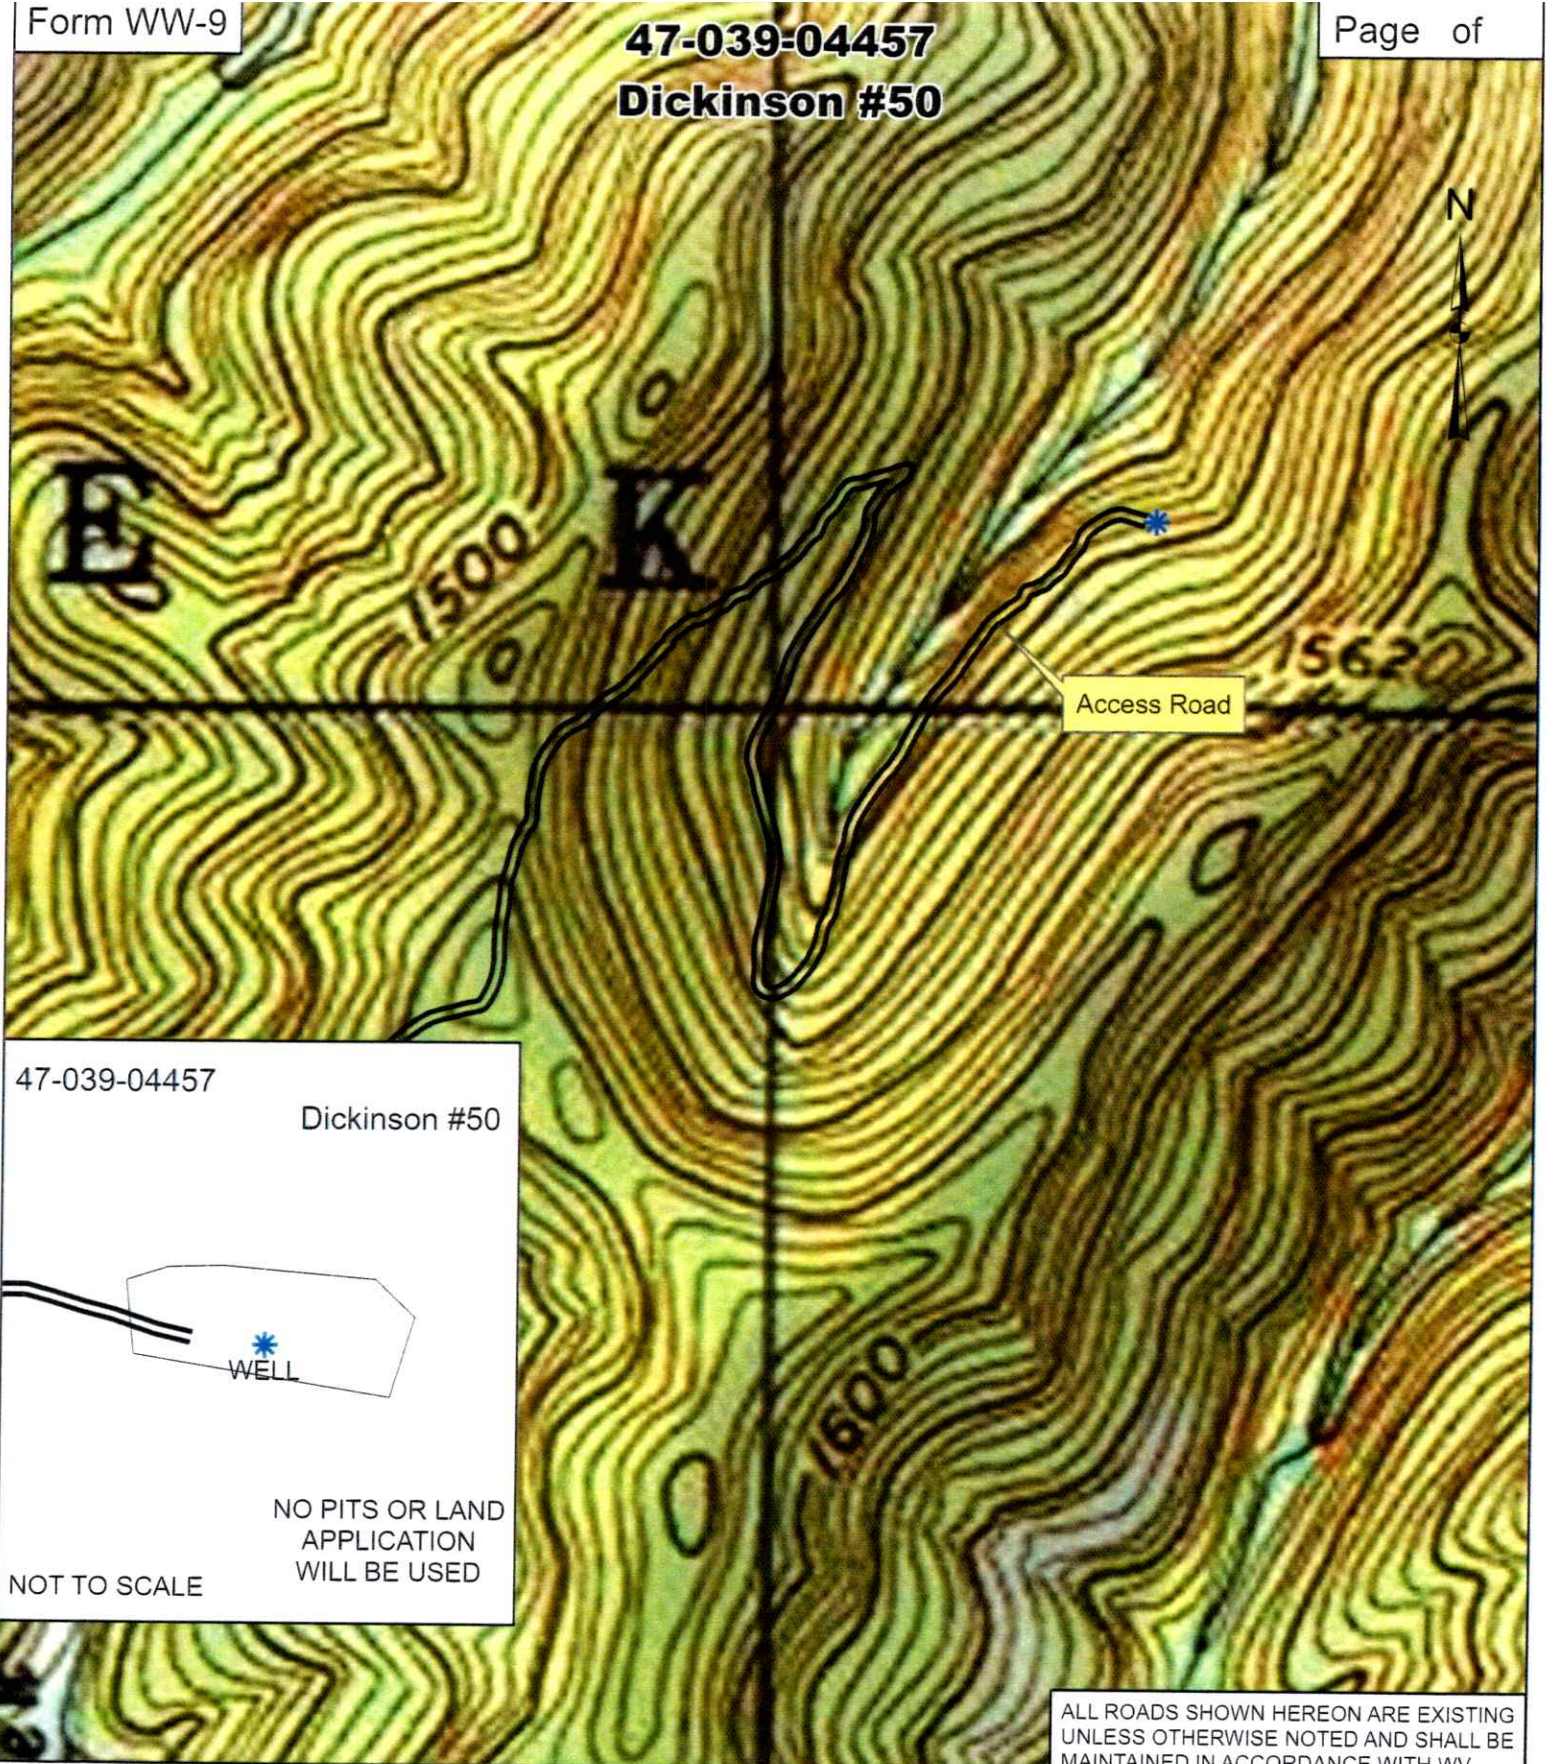

47-039-04457

Dickinson #50



NO PITS OR LAND  
APPLICATION  
WILL BE USED

NOT TO SCALE

ALL ROADS SHOWN HEREON ARE EXISTING UNLESS OTHERWISE NOTED AND SHALL BE MAINTAINED IN ACCORDANCE WITH WV D.E.P. OIL AND GAS BMP MANUAL ENTRANCES AT COUNTY/STATE ROADS SHALL BE MAINTAINED WITH WV D.O.T. REGULATION. SEPARATE PERMITS MAY BE REQUIRED BY D.O.T.

EARTHWORK CONTRACTORS ARE RESPONSIBLE FOR NOTIFICATION TO THE OPERATOR AND INSPECTION PRIOR TO ANY DEVIATION FROM THIS PLAN.

**GREYLOCK**  
ENERGY

Greylock Conventional, LLC

500 Corporate Landing Charleston, WV 25311  
304-925-6100 - www.greylockenergy.com

Date: 5/23/2024

0 150 300 600 900 1,200



Feet

1:6,000



TOPO SECTION OF USGS  
MAMMOTH 7.5' QUADRANGLE

08/09/2024





West Virginia Department of Environmental Protection  
Office of Oil and Gas  
**WELL LOCATION FORM: GPS**

API: 47-039-04457 WELL NO.: 50

FARM NAME: Dickinson

RESPONSIBLE PARTY NAME: Greylock Conventional, LLC

COUNTY: Kanawha DISTRICT: Cabin Creek

QUADRANGLE: Mammoth

SURFACE OWNER: Blue Creek Gas Co.

ROYALTY OWNER: \_\_\_\_\_

UTM GPS NORTHING: 4235141.65

UTM GPS EASTING: 475317.78 GPS ELEVATION: 1,284 ft

The Responsible Party named above has chosen to submit GPS coordinates in lieu of preparing a new well location plat for a plugging permit or assigned API number on the above well. The Office of Oil and Gas will not accept GPS coordinates that do not meet the following requirements:

- Datum: NAD 1983, Zone: 17 North, Coordinate Units: meters, Altitude: height above mean sea level (MSL) – meters.
- Accuracy to Datum – 3.05 meters
- Data Collection Method:

Survey grade GPS \_\_\_\_\_: Post Processed Differential \_\_\_\_\_  
Real-Time Differential \_\_\_\_\_

Mapping Grade GPS X: Post Processed Differential \_\_\_\_\_  
Real-Time Differential X

RECEIVED  
Office of Oil and Gas

JUL 31 2024

West Virginia Department of  
Environmental Protection

- Letter size copy of the topography map showing the well location.**

I the undersigned, hereby certify this data is correct to the best of my knowledge and belief and shows all the information required by law and the regulations issued and prescribed by the Office of Oil and Gas.

G. NR  
Signature

Asset Development Manager  
Title

May 28, 2024  
Date