

3904624P

WW-7
8-30-06



West Virginia Department of Environmental Protection
Office of Oil and Gas
WELL LOCATION FORM: GPS

API: 47-039-04624 WELL NO.: WV 116921 (Shonk Land 14-5)

FARM NAME: Shonk Land Company

RESPONSIBLE PARTY NAME: EQT Production Company

COUNTY: Kanawha DISTRICT: Cabin Creek

QUADRANGLE: Sylvester 7.5'

SURFACE OWNER: Shonk Land Company, LLC

ROYALTY OWNER: Shonk Land Company, LLC, et al.

UTM GPS NORTHING: 4215597

UTM GPS EASTING: 454328 GPS ELEVATION: 358 m (1177 ft)

The Responsible Party named above has chosen to submit GPS coordinates in lieu of preparing a new well location plat for a plugging permit or assigned API number on the above well. The Office of Oil and Gas will not accept GPS coordinates that do not meet the following requirements:

1. Datum: NAD 1983, Zone: 17 North, Coordinate Units: meters, Altitude: height above mean sea level (MSL) – meters.
2. Accuracy to Datum – 3.05 meters
3. Data Collection Method:

Survey grade GPS : Post Processed Differential
Real-Time Differential

Mapping Grade GPS X: Post Processed Differential X
Real-Time Differential

4. Letter size copy of the topography map showing the well location.

I the undersigned, hereby certify this data is correct to the best of my knowledge and belief and shows all the information required by law and the regulations issued and prescribed by the Office of Oil and Gas.

RECEIVED
Office of Oil and Gas
JUL 08 2014

[Signature]
Signature

PS # 2180
Title

WV Department of Environmental Protection
[Date]
Date

3904624P

Topo Quad: Sylvester 7.5'

Scale: 1" = 2000'

County: Kanawha


Date: May 14, 2014

District: Cabin Creek

Project No: 52-14-00-07

47-039-04624 WV 116921 (Shonk Land 14-5)

Topo

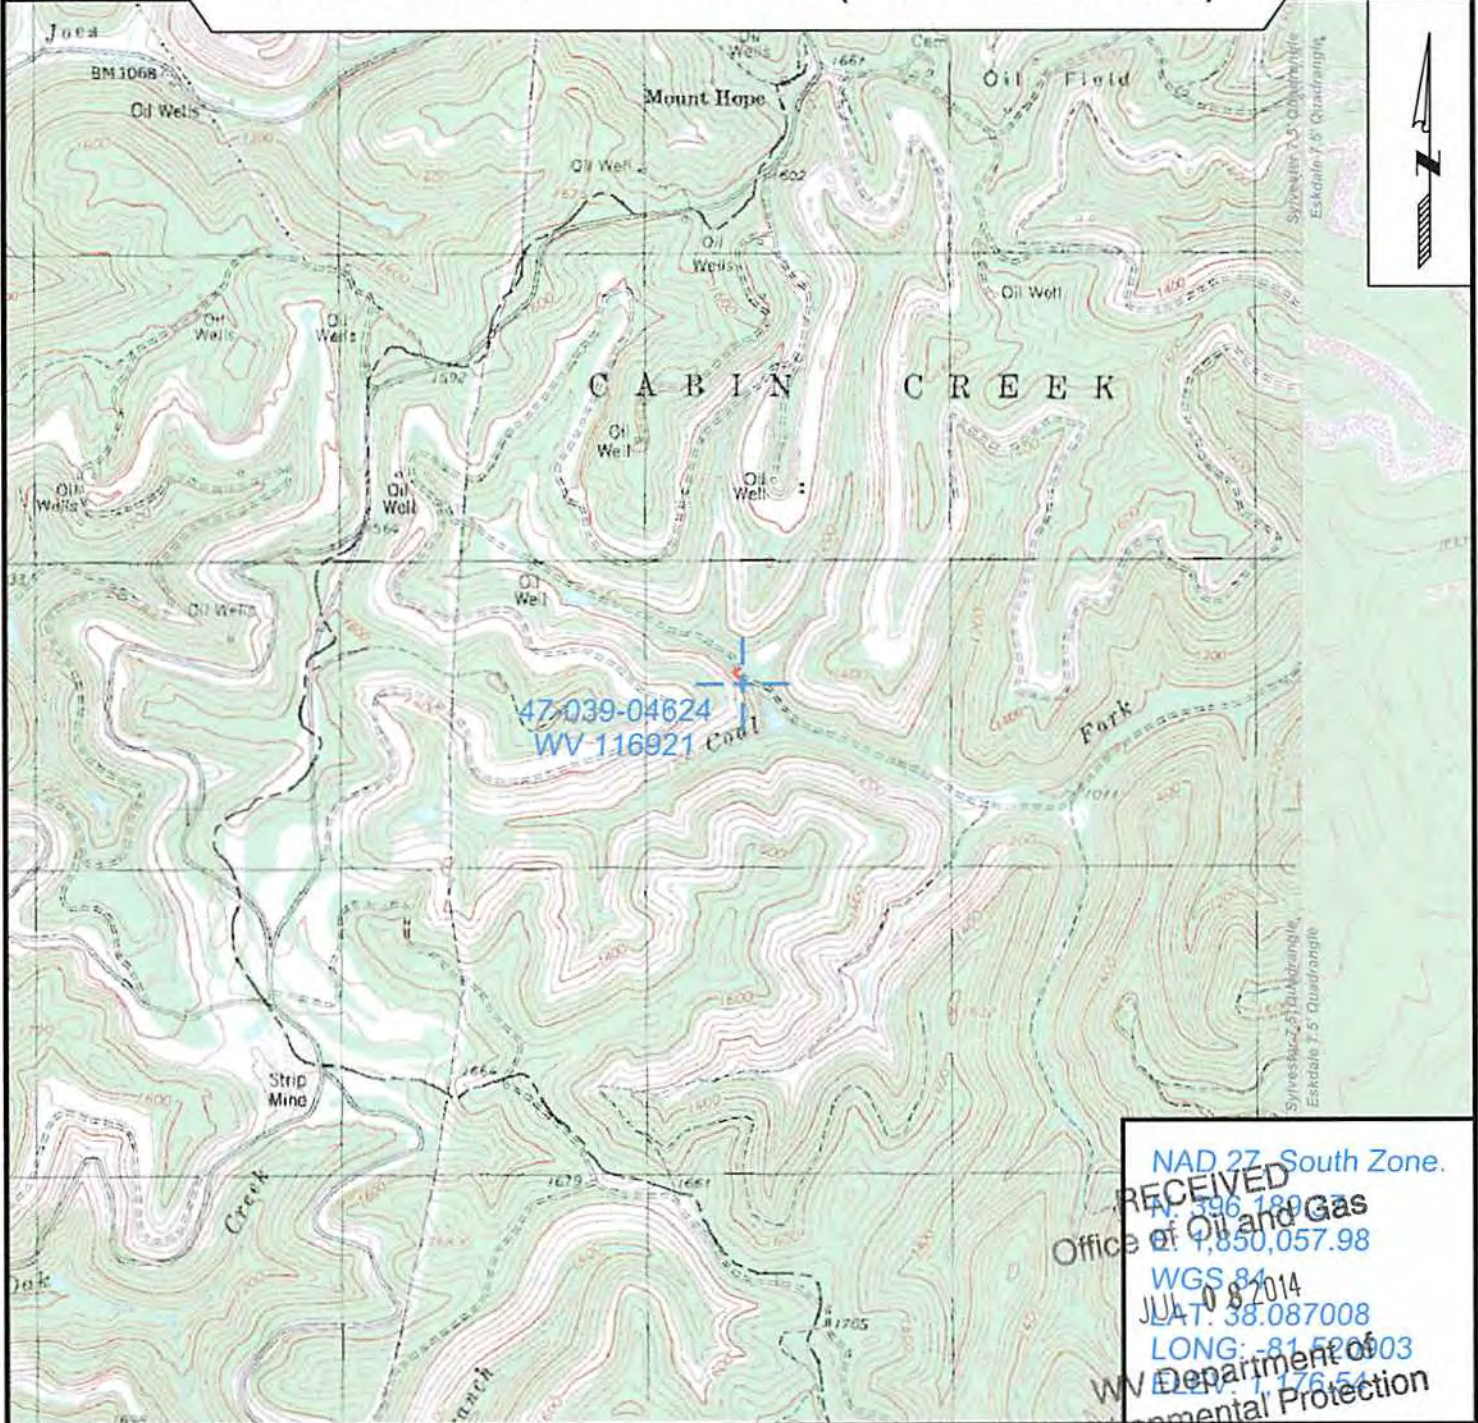

RECEIVED
 NAD 27, South Zone.
 N: 396,189.98
 Office of Oil and Gas
 E: 1,850,057.98
 WGS 84
 JUL 08 2014
 LAT: 38.087008
 LONG: -81.520603
 WV Department of
 Environmental Protection



SURVEYING AND MAPPING SERVICES PERFORMED BY:
ALLEGHENY SURVEYS, INC.
 1-800-482-8606
 237 Birch River Road
 Birch River, WV 26610
 PH: (304) 649-8606
 FAX: (304) 649-8608

PREPARED FOR: Environmental
EQT Production Company
 P.O. Box 280
 Bridgeport, WV 26330