

WW-7  
8-30-06



West Virginia Department of Environmental Protection  
Office of Oil and Gas

**WELL LOCATION FORM: GPS**

API: 47-039-04869 WELL NO.: 10789

FARM NAME: David Gillian

RESPONSIBLE PARTY NAME: CNX Gas Company LLC

COUNTY: Kanawha DISTRICT: Big Creek Union

QUADRANGLE: St. Albans, WV 594

SURFACE OWNER: David Gillian

ROYALTY OWNER: R.L. Critchfield et al

UTM GPS NORTHING: 4,250,010.94 m

UTM GPS EASTING: 430,760.68 m GPS ELEVATION: 278 m (912 FT)

The Responsible Party named above has chosen to submit GPS coordinates in lieu of preparing a new well location plat for a plugging permit or assigned API number on the above well. The Office of Oil and Gas will not accept GPS coordinates that do not meet the following requirements:

- Datum: NAD 1983, Zone: 17 North, Coordinate Units: meters, Altitude: height above mean sea level (MSL) – meters.
- Accuracy to Datum – 3.05 meters
- Data Collection Method:  
Survey grade GPS  : Post Processed Differential

Real-Time Differential

Mapping Grade GPS  : Post Processed Differential

Real-Time Differential

- Letter size copy of the topography map showing the well location.**


I the undersigned, hereby certify this data is correct to the best of my knowledge and belief and shows all the information required by law and the regulations issued and prescribed by the Office of Oil and Gas.

J.M. [Signature]  
Signature

Prod. Coord.  
Title

JUL 08 2014  
7/7/14  
Date

WV Department of  
Environmental Protection

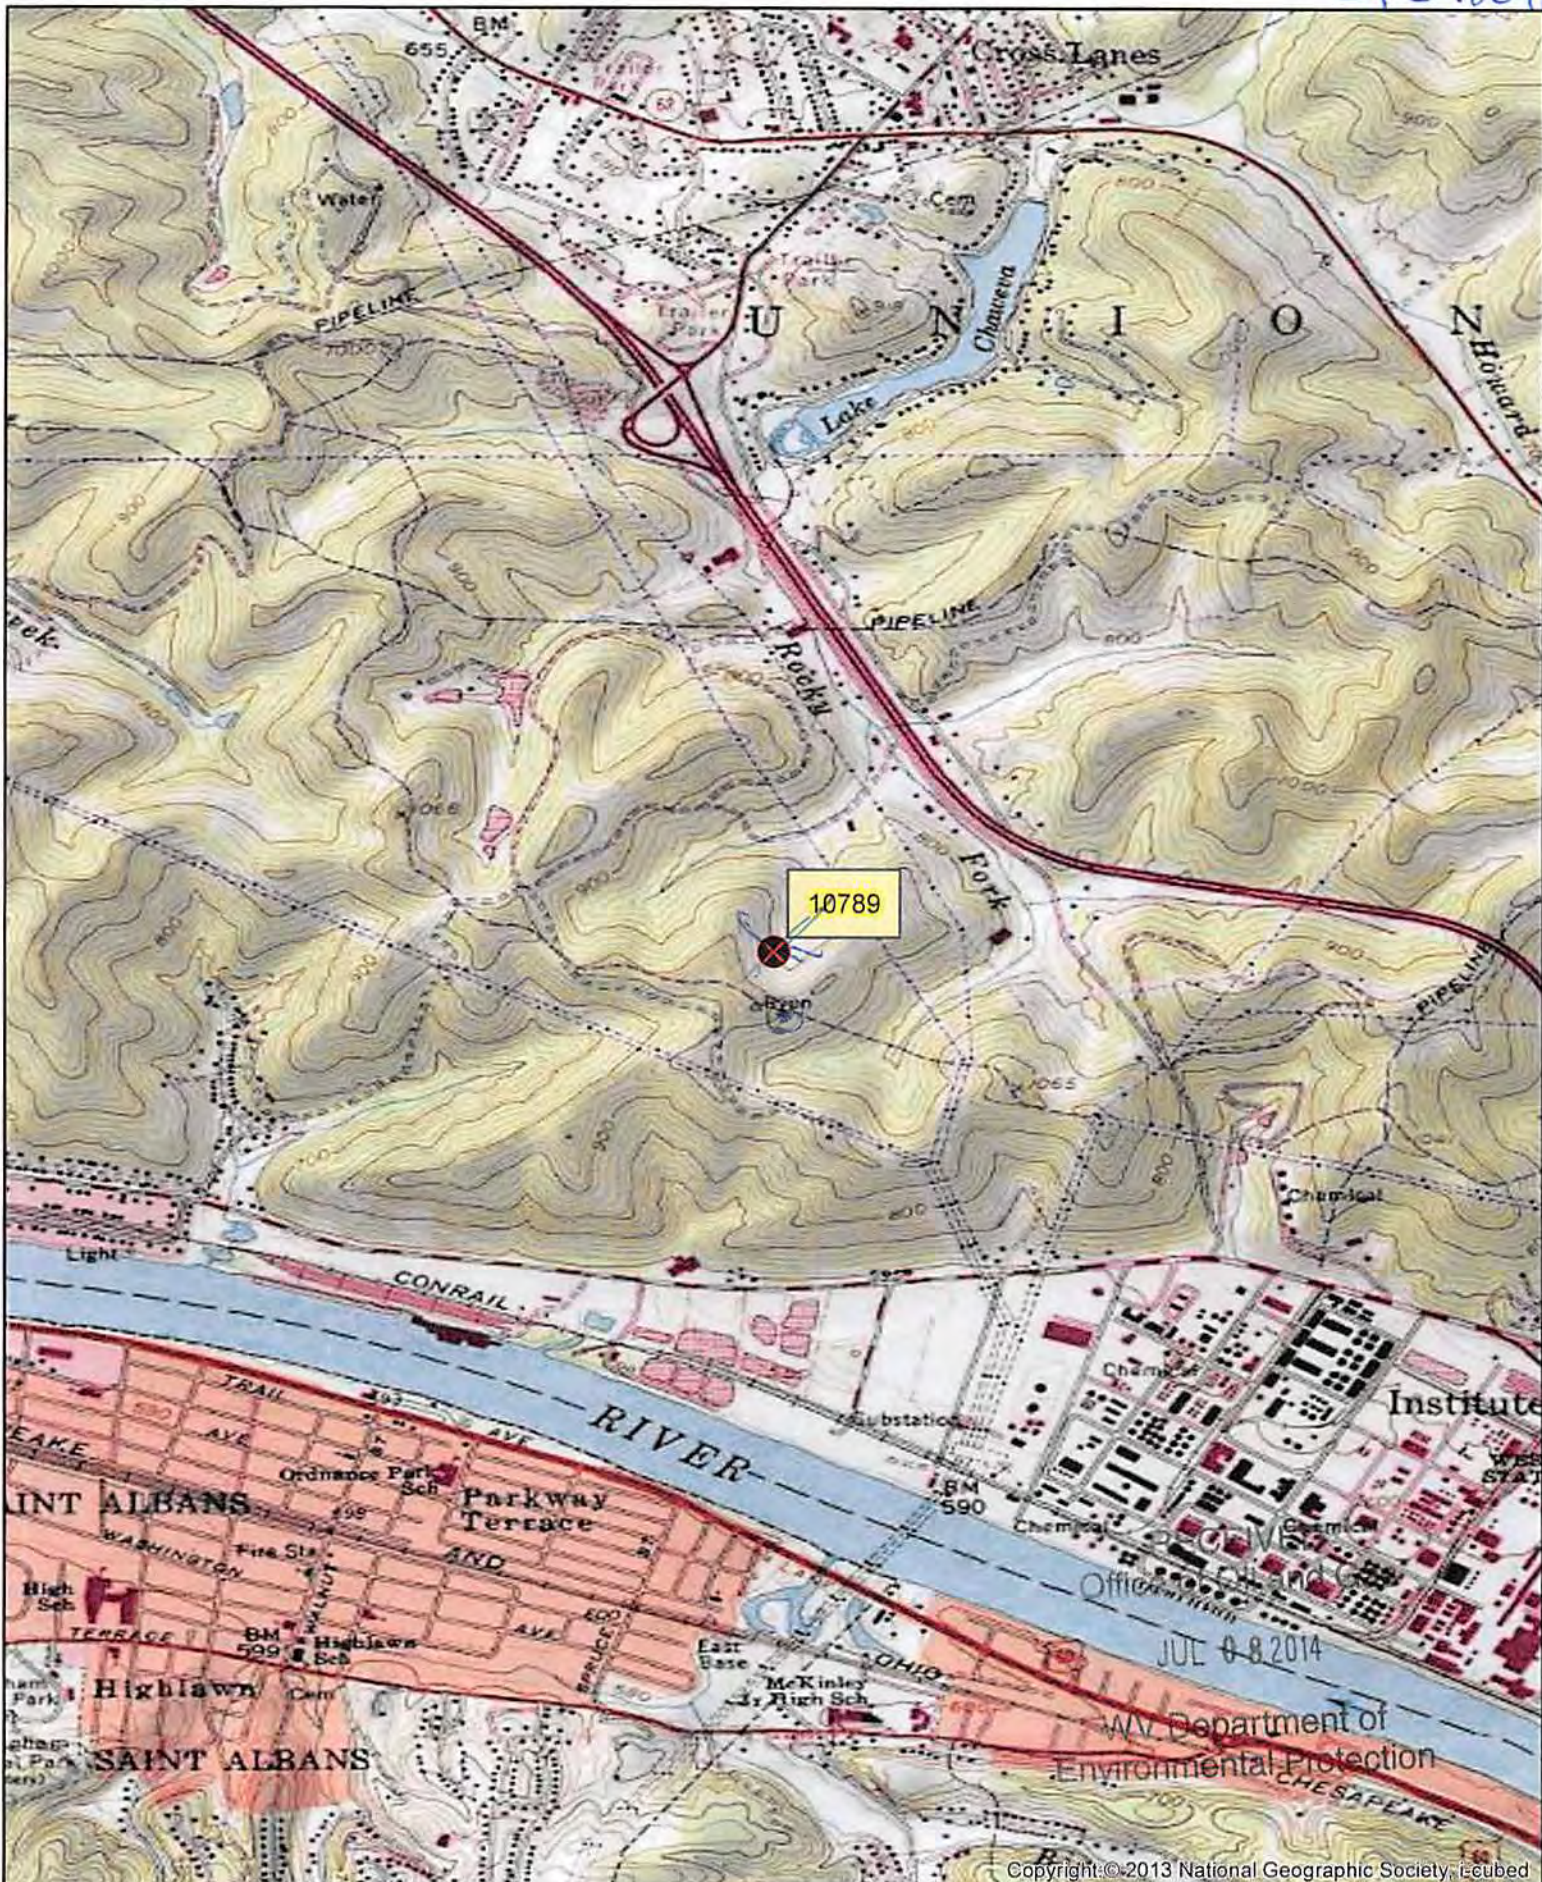

Disclaimer: This information is being provided as a business or professional courtesy. CONSOL Energy Inc., its subsidiaries and affiliates, collectively "CEI", make no representations or warranties of any kind or character concerning the completeness or accuracy of this information and assumes no responsibility or liability of any kind for such information. The Recipient of this information acknowledges and assumes all risk of the use of such information. In consideration of CEI providing this information, the recipient forever waives and releases any and all claims or causes of action the Recipient may ever have against CEI, its officers, directors, employees or agents relating to or resulting or arising from its use of the information. Acceptance of this information by the recipient constitutes agreement with all the terms and conditions in the notice.

Date: 5/9/2014		Prepared By: KK	
Revisions:		Approved By: BS	
This map is property of CONSOL Energy Inc. and contains information that is proprietary and confidential in nature and may not be copied or reproduced without prior written consent.			

**CONSOL ENERGY**

**PROPOSED PLUGGING  
WELL NUMBER 10789  
API# 47-039-04869  
GENERAL LOCATION MAP**