

Oil&Gas

Wells, Horizontal Only

WellStatus

- Active Well
- Permit Issued
- Permit Application
- Plugged


Wells, Active Status Only

WellUse

- Brine Disposal
- Fluid Injection
- Gas Production
- House Gas
- Observation
- Oil Production
- Production
- Solution Mining
- Storage
- Vent
- <all other values>

Wells, Other than Active Status

WellUse

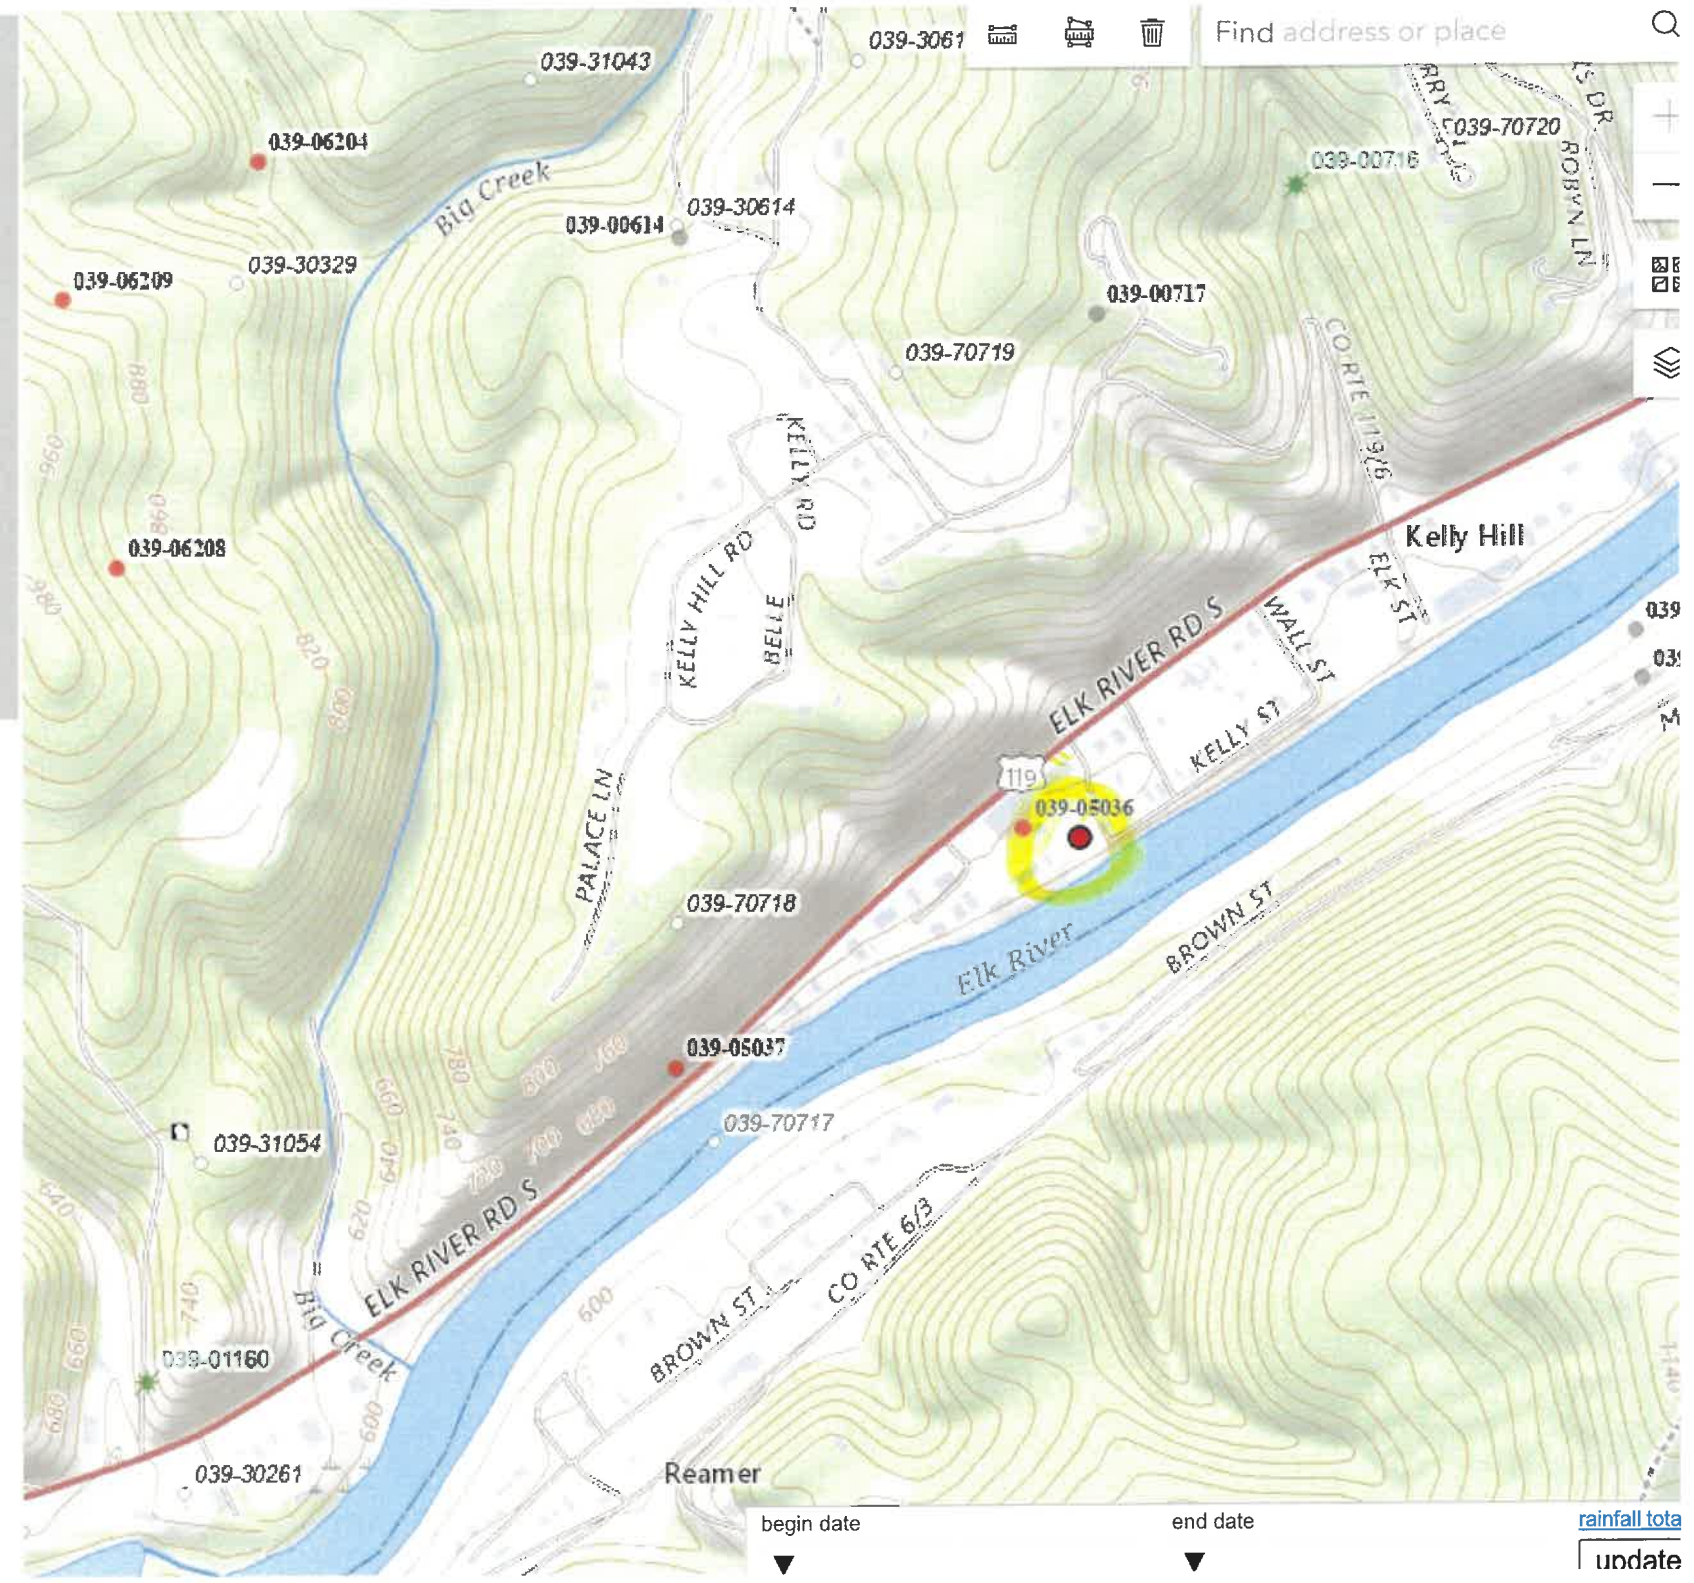

begin date	end date	rainfall tota
▼	▼	update



West Virginia Department of Environmental Protection
Office of Oil and Gas

WELL LOCATION FORM: GPS

API: 47-039-05036 WELL NO.: #1

FARM NAME: Rebecca Lowery Hrs.

RESPONSIBLE PARTY NAME: Robert A Richards

COUNTY: Kanawha DISTRICT: BIG SANDY

QUADRANGLE: Clendenin

SURFACE OWNER: Clendenin Pentecostal Church

ROYALTY OWNER: Lowery Hrs.

UTM GPS NORTHING: 4259234

UTM GPS EASTING: 468015 GPS ELEVATION: 620'

The Responsible Party named above has chosen to submit GPS coordinates in lieu of preparing a new well location plat for a plugging permit or assigned API number on the above well. The Office of Oil and Gas will not accept GPS coordinates that do not meet the following requirements:

1. Datum: NAD 1983, Zone: 17 North, Coordinate Units: meters, Altitude: height above mean sea level (MSL) – meters.
2. Accuracy to Datum – 3.05 meters
3. Data Collection Method:
Survey grade GPS ____: Post Processed Differential ____

Real-Time Differential ____

Mapping Grade GPS : Post Processed Differential ____

Real-Time Differential ____

4. Letter size copy of the topography map showing the well location.

I the undersigned, hereby certify this data is correct to the best of my knowledge and belief and shows all the information required by law and the regulations issued and prescribed by the Office of Oil and Gas.

[Signature]
Signature

[Title]
Title

4/17/23
Date

RECEIVED
Office of Oil and Gas
MAY 08 2023
WV Department of
Environmental Protection