



West Virginia Department of Environmental Protection  
Office of Oil and Gas  
**WELL LOCATION FORM: GPS**

API: 47-39-05941 WELL NO.: 2

FARM NAME: Earl Hill

RESPONSIBLE PARTY NAME: Steve Rubin

COUNTY: Kanawha DISTRICT: Jefferson

QUADRANGLE: Alum Creek

SURFACE OWNER: Earl Hill

ROYALTY OWNER: Earl Hill

UTM GPS NORTHING: N38.32941 4242635.153

UTM GPS EASTING: N081.25602 GPS ELEVATION: 935'  
433921.026

The Responsible Party named above has chosen to submit GPS coordinates in lieu of preparing a new well location plat for a plugging permit or assigned API number on the above well. The Office of Oil and Gas will not accept GPS coordinates that do not meet the following requirements:

1. Datum: NAD 1983, Zone: 17 North, Coordinate Units: meters, Altitude: height above mean sea level (MSL) – meters.
2. Accuracy to Datum – 3.05 meters
3. Data Collection Method:

Survey grade GPS : Post Processed Differential

Real-Time Differential

Mapping Grade GPS : Post Processed Differential

Real-Time Differential

RECEIVED  
Office of Oil and Gas

OCT 26 2015


4. Letter size copy of the topography map showing the well location. I, the undersigned, hereby certify this data is correct to the best of my knowledge and belief and shows all the information required by law and the regulations issued and prescribed by the Office of Oil and Gas.

Steve Rubin  
Signature

Contractor  
Title

10-26-15  
Date

39-5961P

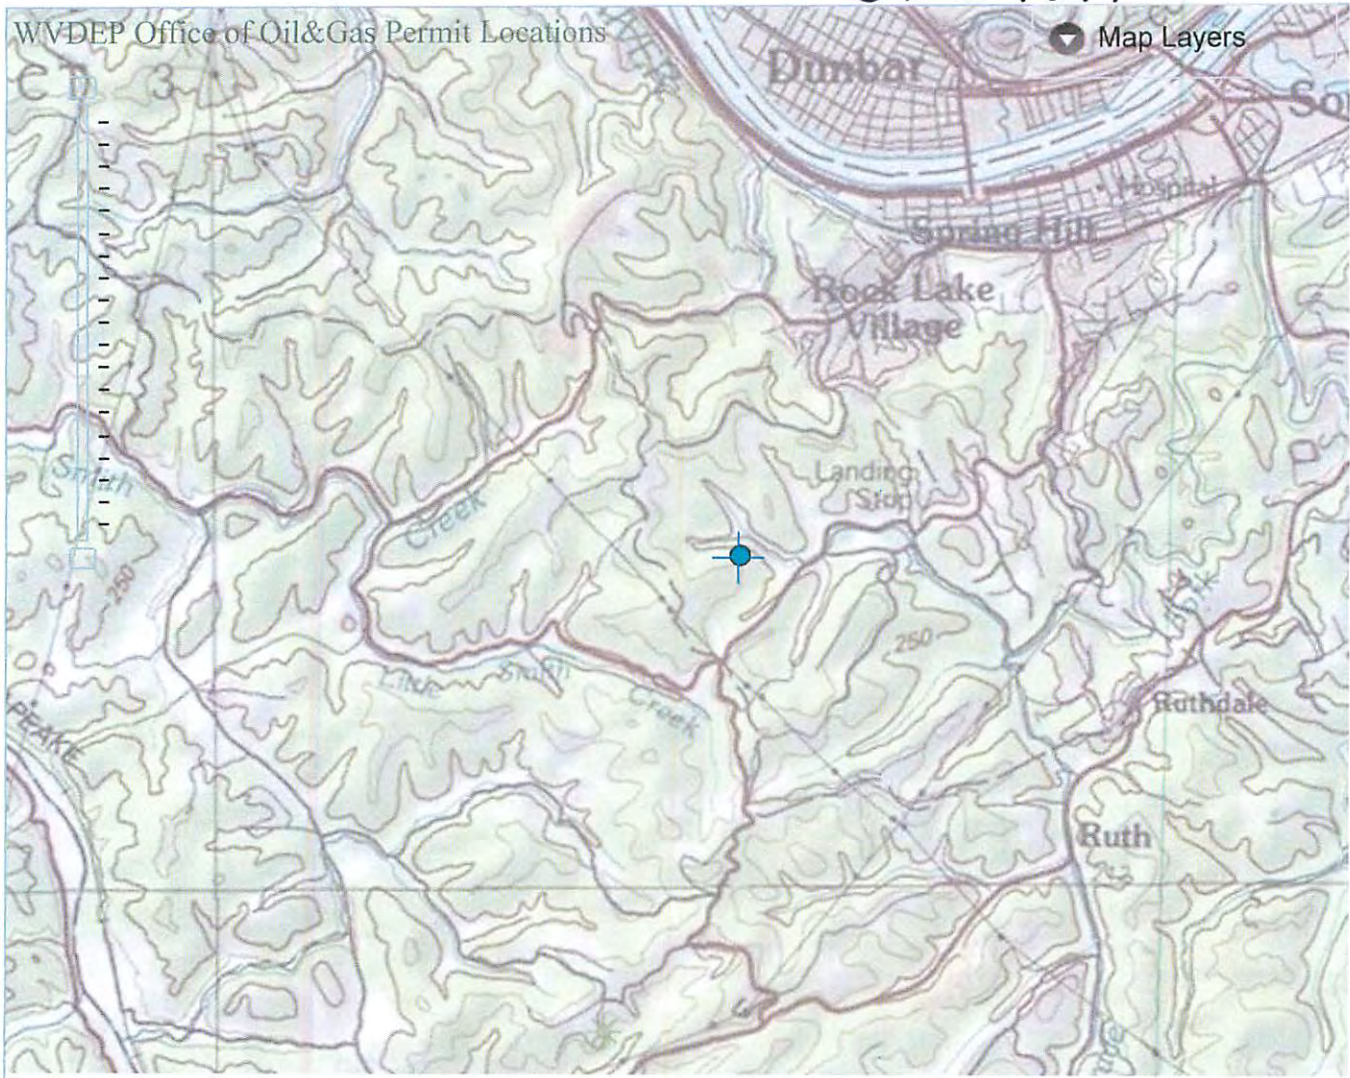

[Attribute Search](#) | 
 [Results](#) | 
 [Legend](#) | 
 [Location Search](#) | 
 [About](#)

| API       | Permit Type | Received   | Issued     | Complete   | Operator               |
|-----------|-------------|------------|------------|------------|------------------------|
| 039-05961 | Plugging    | 2015-10-26 | NA         | NA         | BLUE CREEK GAS COMPANY |
| 039-05961 | Plugging    | 2015-10-26 | NA         | NA         | BLUE CREEK GAS COMPANY |
| 039-05961 | New Well    | 2007-01-17 | 2007-01-17 | 2007-06-22 | BLUE CREEK GAS COMPANY |

