


UTM NAD 83  
 17 0448 052E  
 42 48088N  
 NAD 83  
 LAT. 38.3794784N  
 LONG. 81.5947549W

LATITUDE 38°25'00"  
 39106327R

LINE	BEARING	DISTANCE
L1	S 48°19'33" W	899.85
L2	N 22°12'10" E	2187.89
L3	N 42°28'22" E	1063.59
L4	N 59°41'13" E	568.08

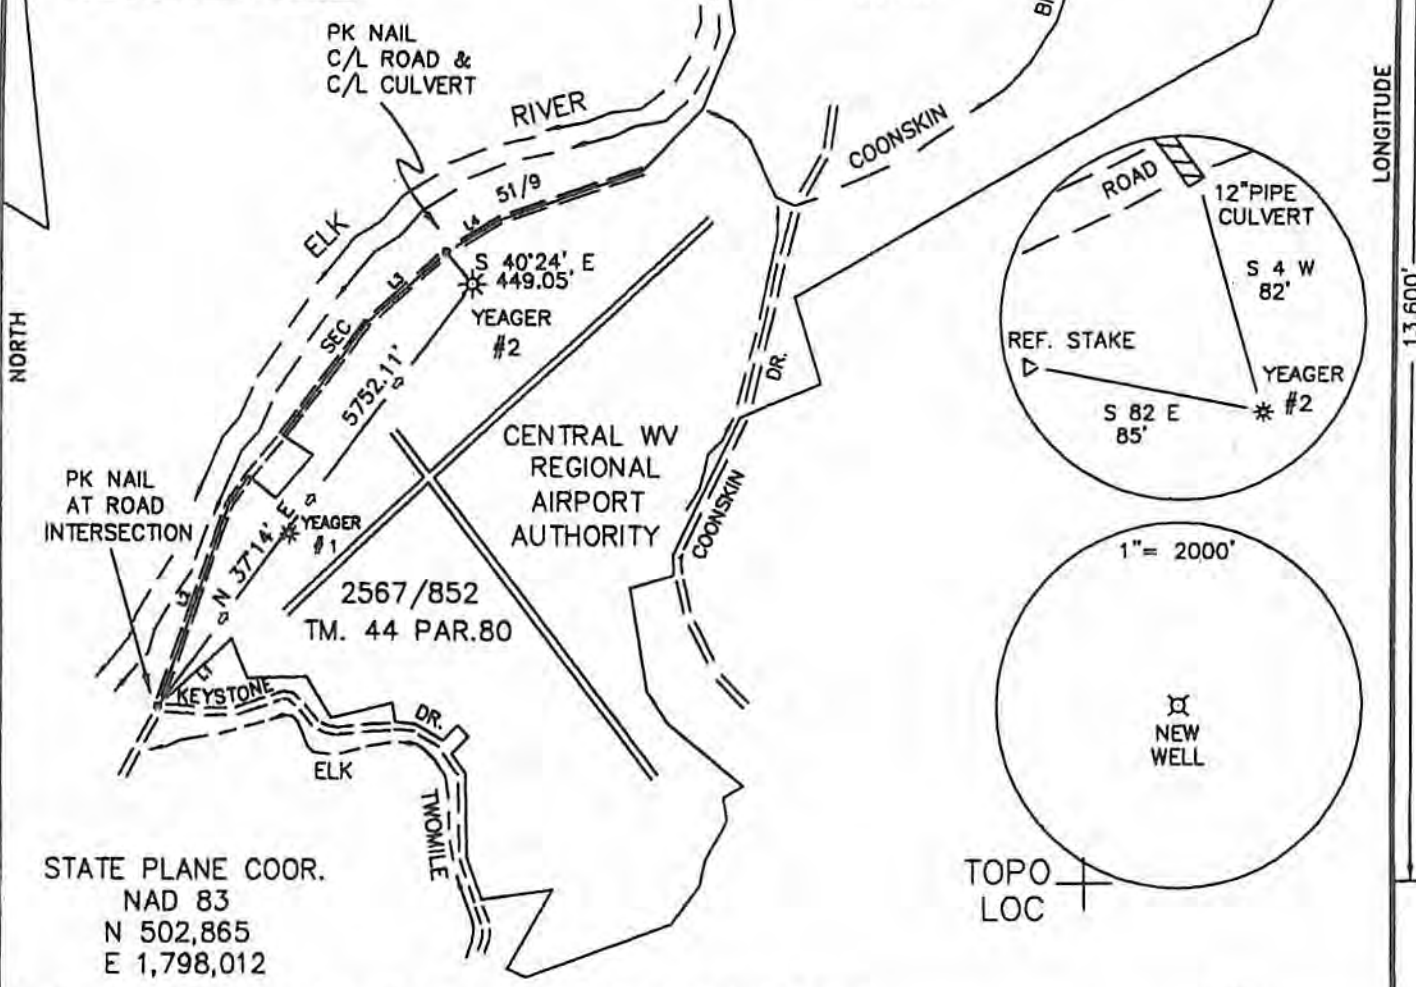

STATE PLANE COOR.  
 NAD 83  
 N 502,865  
 E 1,798,012

(+) DENOTES LOCATION OF WELL ON UNITED STATES TOPOGRAPHIC MAPS

FILE NO. \_\_\_\_\_  
 DRAWING NO. 11-35  
 SCALE 1"=2000'  
 MINIMUM DEGREE OF ACCURACY 1 IN 200  
 PROVEN SOURCE OF ELEVATION GPS

I THE UNDERSIGNED, HEREBY CERTIFY THAT THIS PLAT IS CORRECT TO THE BEST OF MY KNOWLEDGE AND BELIEF AND SHOWS ALL THE INFORMATION REQUIRED BY LAW AND THE REGULATIONS ISSUED AND PRESCRIBED BY THE DEPARTMENT OF ENERGY.  
 (SIGNED) *[Signature]*  
 R.P.E. \_\_\_\_\_ L.L.S. 851

PLACE SEAL HERE

STATE OF WEST VIRGINIA  
 Department of Environmental Protection  
 OFFICE OF OIL AND GAS

DATE 11/16, 20 11  
 OPERATOR'S WELL NO. YEAGER #2  
 API WELL NO. \_\_\_\_\_  
47 - 39 - 06327R  
 STATE COUNTY PERMIT

WELL TYPE: OIL  GAS  LIQUID INJECTION  WASTE DISPOSAL   
 (IF "GAS") PRODUCTION  STORAGE  DEEP  SHALLOW

LOCATION: ELEVATION 675 WATER SHED ELK RIVER  
 DISTRICT ELK COUNTY KANAWHA  
 QUADRANGLE BIG CHIMNEY


SURFACE OWNER CENTRAL WV REGIONAL AIRPORT AUTHORITY ACREAGE 1214.61  
 OIL & GAS ROYALTY OWNER CENTRAL WV REGIONAL AIRPORT AUTHORITY LEASE ACREAGE 1214.61  
 LEASE NO. \_\_\_\_\_

PROPOSED WORK: DRILL  CONVERT  DRILL DEEPER  REDRILL  FRACTURE OR STIMULATE  PLUG OFF OLD FORMATION  PERFORATE NEW FORMATION  OTHER PHYSICAL CHANGE IN WELL (SPECIFY): \_\_\_\_\_

PLUG AND ABANDON  CLEAN OUT AND REPLUG

TARGET FORMATION BASE OF LOWER HURON/RHINESTREET ESTIMATED DEPTH 5500  
 WELL OPERATOR RESERVE OIL & GAS INC. DESIGNATED AGENT J. SCOTT FRESHWATER  
 ADDRESS 929 CHARLESTON ROAD ADDRESS 929 CHARLESTON ROAD  
SPENCER, WV 25276 SPENCER, WV 25276

Received  
 APR 16 2014  
 Office of Oil and Gas  
 WV Dept. of Environmental Protection  
 05/02/2014

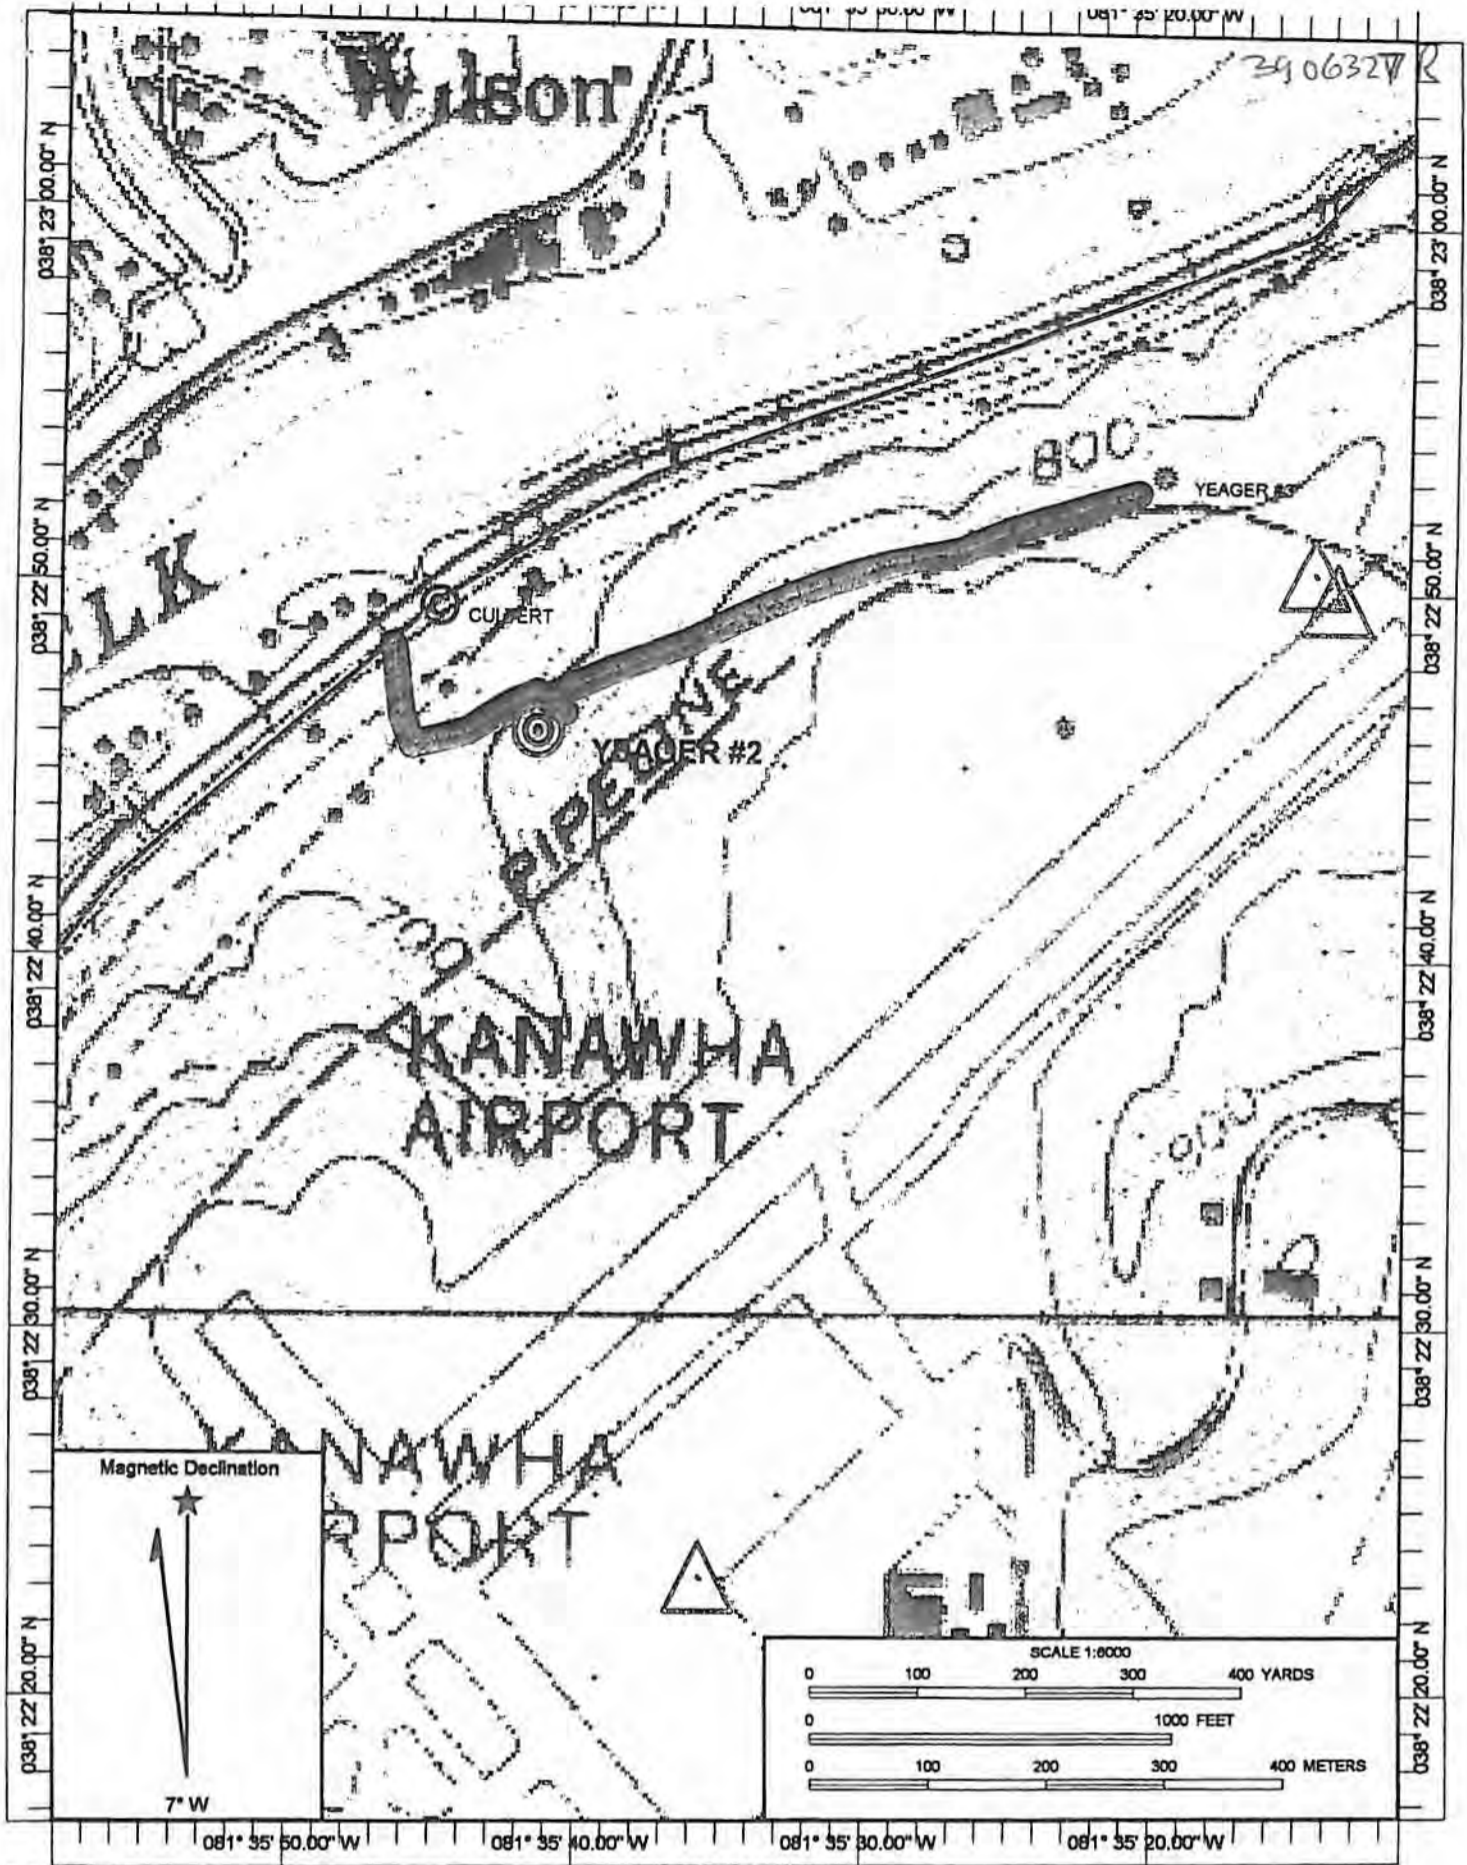

Datum: NAD83

Copyright (C) 1997, Maptech, Inc.

39-06327

Received

APR 16 2014

Office of Oil and Gas  
WV Dept. of Environmental Protection

05/02/2014