

NOTE: NO BUILDING STRUCTURES IDENTIFIED WITHIN 200'

WELL SITE
STATE PLANE WV SOUTH ZONE NAD 1927 N - 529,343.52 : E - 1,806,988.44
LATITUDE: (N) 38.4507324° LONGITUDE: (W) 81.6742065°
UTM, NAD83 17 - 84W TO 78W, METERS N - 4,256,052.237 : E - 441,183.550

(+) DENOTES LOCATION OF WELL ON UNITED STATES TOPOGRAPHIC MAPS

FILE NO.	LOG JOHN FLEMING #4.DGN
DRAWING NO.	JOHN FLEMING #4
SCALE	1" = 1000'
MINIMUM DEGREE OF ACCURACY	1:200
PROVEN SOURCE OF ELEVATION	MAPPING GRADE GPS

I THE UNDERSIGNED, HEREBY CERTIFY THAT THIS PLAT IS CORRECT TO THE BEST OF MY KNOWLEDGE AND BELIEF AND SHOWS ALL THE INFORMATION REQUIRED BY LAW AND THE REGULATIONS ISSUED AND PRESCRIBED BY THE DEPARTMENT OF ENVIRONMENTAL PROTECTION.

(SIGNED) *Paul E. Miller*
R.P.E. _____ L.L.S. 647

REFERENCES: 1" = 200'

PAUL E. MILLER
LICENSED
No. 647
STATE OF WEST VIRGINIA
PROFESSIONAL SURVEYOR
PLACE SEAL HERE

STATE OF WEST VIRGINIA
DIVISION OF ENVIRONMENTAL PROTECTION
OIL AND GAS DIVISION



DATE FEBRUARY 03, 20 12
OPERATOR'S WELL NO. JOHN FLEMING #4
API WELL NO.

WELL TYPE: OIL ___ GAS ___ LIQUID INJECTION ___ WASTE DISPOSAL ___
(IF "GAS,") PRODUCTION STORAGE ___ DEEP ___ SHALLOW

LOCATION: ELEVATION 918' WATER SHED MUNDY HOLLOW OF LANE BRANCH
DISTRICT _____ UNION _____ COUNTY KANAWHA
QUADRANGLE POCATALICO, WV 7.5'

SURFACE OWNER JOHN FLEMING ACREAGE 63.79
OIL & GAS ROYALTY OWNER JOHN FLEMING & COFFMAN HRS. LEASE ACREAGE _____
LEASE NO. _____


PROPOSED WORK: DRILL CONVERT ___ DRILL DEEPER ___ REDRILL ___ FRACTURE OR
STIMULATE PLUG OFF OLD FORMATION ___ PERFORATE NEW
FORMATION ___ OTHER PHYSICAL CHANGE IN WELL (SPECIFY) _____

PLUG AND ABANDON ___ CLEAN OUT AND REPLUG ___
TARGET FORMATION SHALE ESTIMATED DEPTH _____
WELL OPERATOR LARCH OIL & GAS CORPORATION DESIGNATED AGENT JIMMY LARCH
ADDRESS 5 KIMERIC LANE, CROSS LANES, WV 25313 ADDRESS SAME

COUNTY NAME
PERMIT

FORM WV-6

39-00337

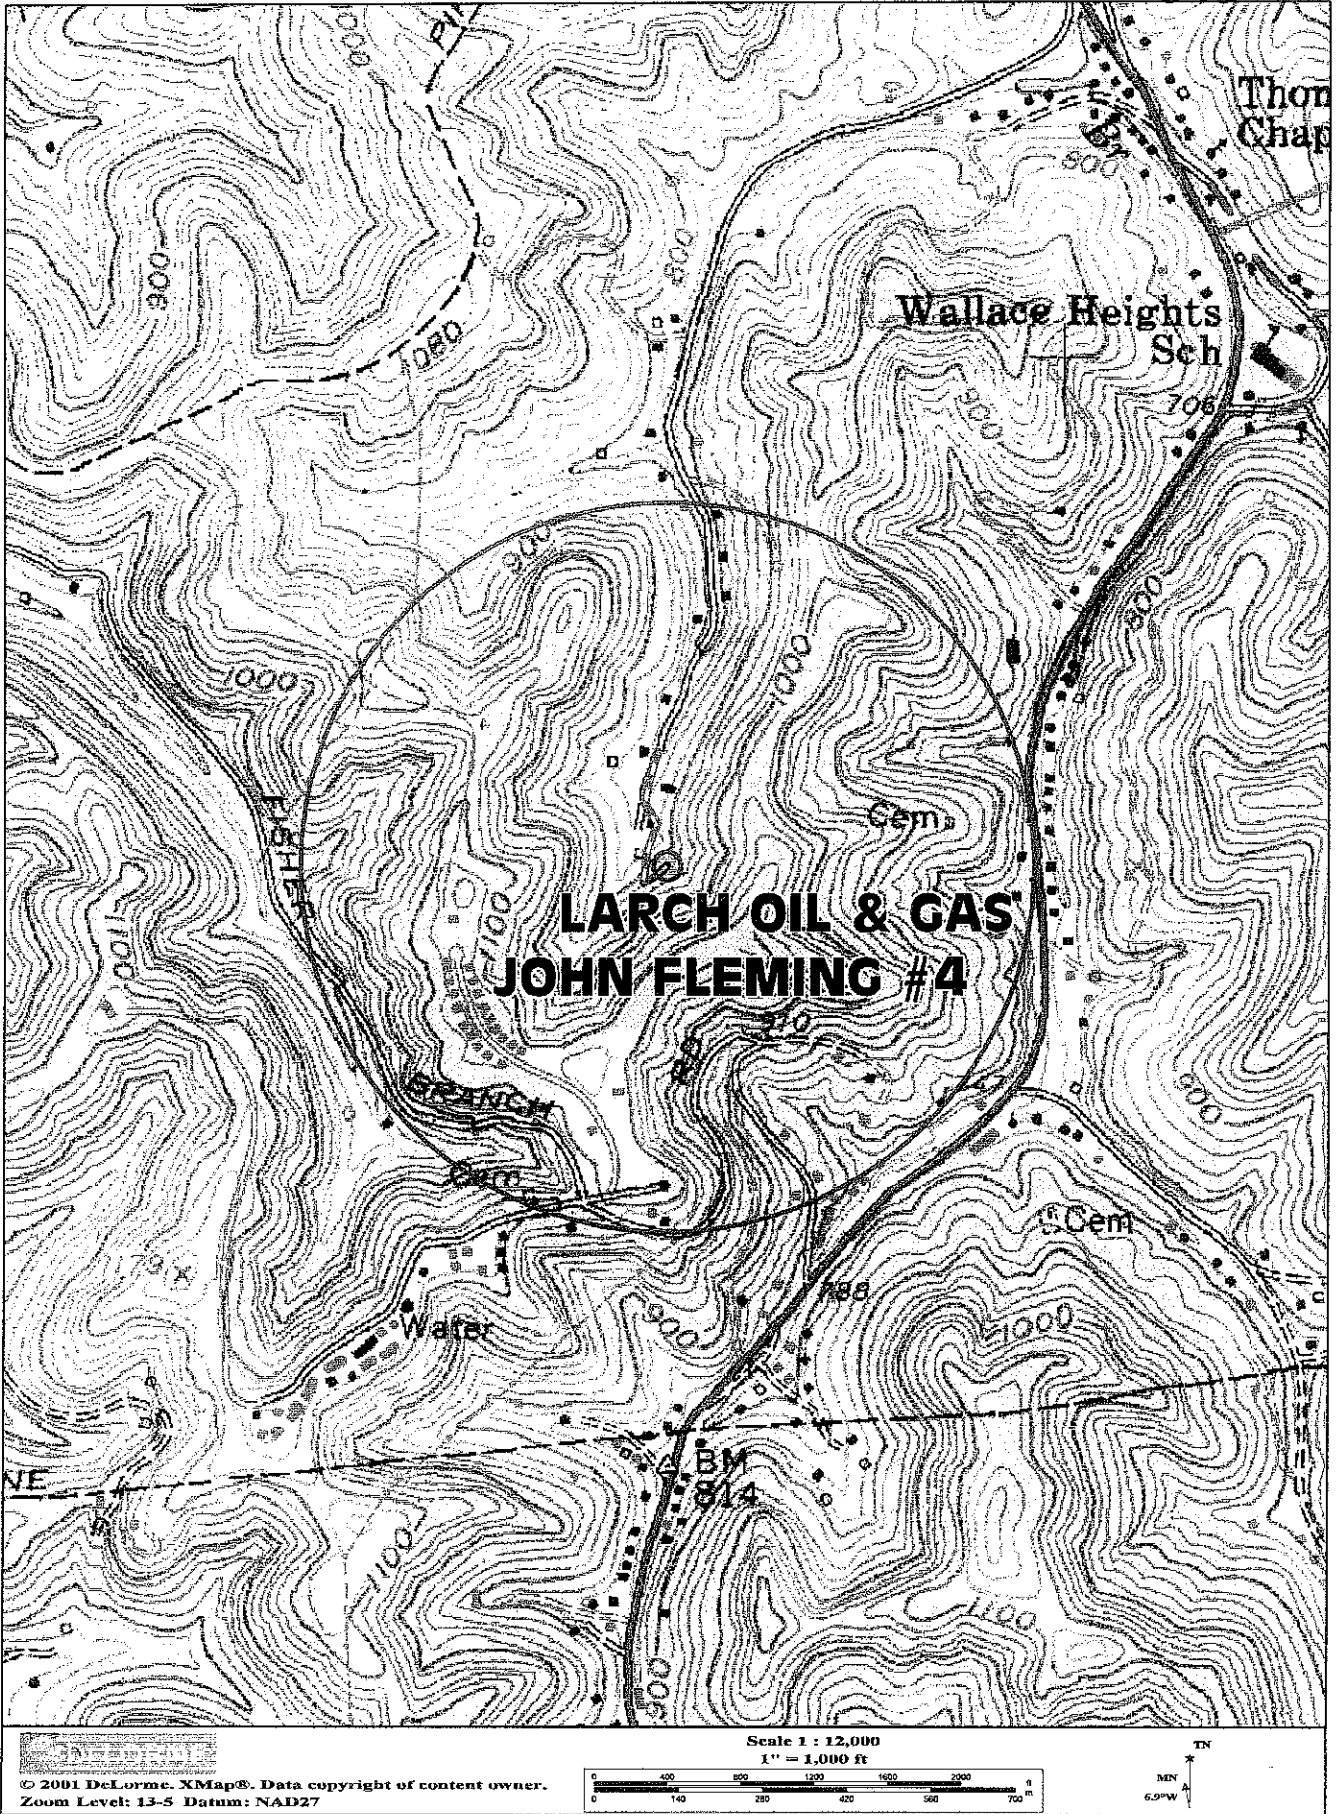

Jimmy, we did not identify water sources (wells).
 Here is a map you can use to do so. The state
 requires 2000' now. This circle is 2000' radius

Angela Miller
 3/6/12

OK REVISION
 OK 3/13/12
 MAR 13 2012
 EMISSIONS

03/30/2012