

LINE	BEARING	DISTANCE
L1	N 18°41' W	25.03'
L2	N 17°54' W	10.64'
L3	S 19°28' E	115.87'
L4	S 10°42' E	162.96'
L5	S 17°34' E	173.30'
L6	S 10°45' E	88.38'
L7	S 14°22' E	104.55'
L8	N 47°12' W	150.00'
L9	N 42°27' W	50.00'
L10	N 42°28' W	99.68'
L11	N 34°39' W	110.00'
L12	N 26°19' W	110.00'
L13	N 22°46' W	155.00'
L14	N 22°40' W	130.20'
L15	N 04°01' W	71.80'
L16	N 03°58' W	200.25'
L17	N 07°00' W	93.86'
L18	N 17°45' W	90.64'

LATITUDE 38°25'00"

UTM NAD.83
ZONE 17
0435759E
4249976N

JOSEPH MARCUM
2171/216
TM 29 PAR 24.4

NORMA ROCKER
2015/624
TM 29 PAR 27

WALTER CLARK
956/184
TM 29 PAR 39

ROY COX
1648/681
TM 29 PAR 29

DONALD LOY
1911/612
TM 29 PAR 42.1

HAROLD CLARK
1652/630
TM 29 PAR 42

PRESSURE PRODUCTS CO INC
TM 29 PAR 40 & 40.1



STATE PLANE COOR.
NAD 83
N 509,062
E 1,757,669

NORTH

LONGITUDE 81°42'30"

STATE RT. 62

TOPO
LOC

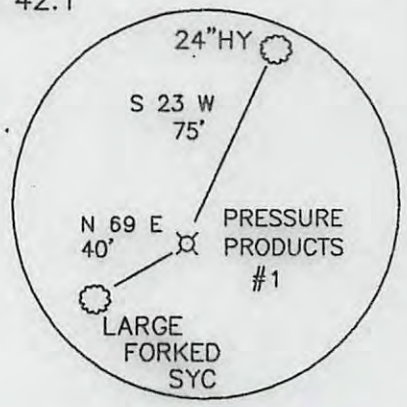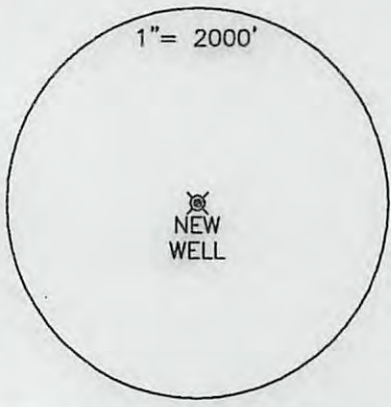

(+) DENOTES LOCATION OF WELL ON UNITED STATES TOPOGRAPHIC MAPS

FILE NO. _____
DRAWING NO. 13-22
SCALE 1"=400'
MINIMUM DEGREE OF ACCURACY 1 IN 200
PROVEN SOURCE OF ELEVATION GPS

I THE UNDERSIGNED, HEREBY CERTIFY THAT THIS PLAT IS CORRECT TO THE BEST OF MY KNOWLEDGE AND BELIEF AND SHOWS ALL THE INFORMATION REQUIRED BY LAW AND THE REGULATIONS ISSUED AND PRESCRIBED BY THE DEPARTMENT OF ENERGY.

(SIGNED) *[Signature]*

R.P.E. _____ L.I.S. 851



STATE OF WEST VIRGINIA
Department of Environmental Protection
OFFICE OF OIL AND GAS

DATE JUNE 10, 2013
OPERATOR'S WELL NO. PRESSURE PRODUCTS #1
API WELL NO. 47-039-06361
STATE COUNTY PERMIT

WELL TYPE: OIL GAS LIQUID INJECTION WASTE DISPOSAL
(IF "GAS") PRODUCTION STORAGE DEEP SHALLOW

LOCATION: ELEVATION 910 WATER SHED LANDERS CREEK OF TYLER CREEK
DISTRICT UNION COUNTY KANAWHA
QUADRANGLE POCATALICO

SURFACE OWNER PRESSURE PRODUCTS CO INC ACREAGE 32.01
OIL & GAS ROYALTY OWNER PRESSURE PRODUCTS CO INC LEASE ACREAGE 32.01
LEASE NO.

PROPOSED WORK: DRILL CONVERT DRILL DEEPER REDRILL FRACTURE OR STIMULATE PLUG OFF OLD FORMATION PERFORATE NEW FORMATION OTHER PHYSICAL CHANGE IN WELL (SPECIFY):

PLUG AND ABANDON CLEAN OUT AND REPLUG

TARGET FORMATION BASE OF LOWER HURON/RHINESTREET ESTIMATED DEPTH 5500
WELL OPERATOR RESERVE OIL & GAS INC. DESIGNATED AGENT J. SCOTT FRESHWATER
ADDRESS 929 CHARLESTON ROAD ADDRESS 929 CHARLESTON ROAD
SPENCER, WV 25276 SPENCER, WV 25276

08/09/2013

3906361

