

WW-7
8-30-06



Received
AUG 7 2013

Office of Oil and Gas
WV Dept. of Environmental Protection

West Virginia Department of Environmental Protection
Office of Oil and Gas

WELL LOCATION FORM: GPS

API: 4703906364 N WELL NO.: 28

FARM NAME: James f. Brown IV

RESPONSIBLE PARTY NAME: Blue Group Energy, Inc.

COUNTY: Kanawha DISTRICT: Big Sandy

QUADRANGLE: Clendenin

SURFACE OWNER: James E. White, Sr

ROYALTY OWNER: James F. Brown IV

UTM GPS NORTHING: ~~4260205~~ 4260197

UTM GPS EASTING: ~~170468170~~ 468185 GPS ELEVATION: 1033'

The Responsible Party named above has chosen to submit GPS coordinates in lieu of preparing a new well location plat for a plugging permit or assigned API number on the above well. The Office of Oil and Gas will not accept GPS coordinates that do not meet the following requirements:

1. Datum: NAD 1983, Zone: 17 North, Coordinate Units: meters, Altitude: height above mean sea level (MSL) – meters.
2. Accuracy to Datum – 3.05 meters
3. Data Collection Method:

Survey grade GPS _____: Post Processed Differential _____


Real-Time Differential _____


Mapping Grade GPS : Post Processed Differential

Real-Time Differential _____

4. Letter size copy of the topography map showing the well location.

I the undersigned, hereby certify this data is correct to the best of my knowledge and belief and shows all the information required by law and the regulations issued and prescribed by the Office of Oil and Gas.

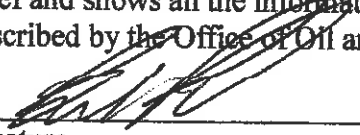
 Signature _____ Title president Date 7/23/13

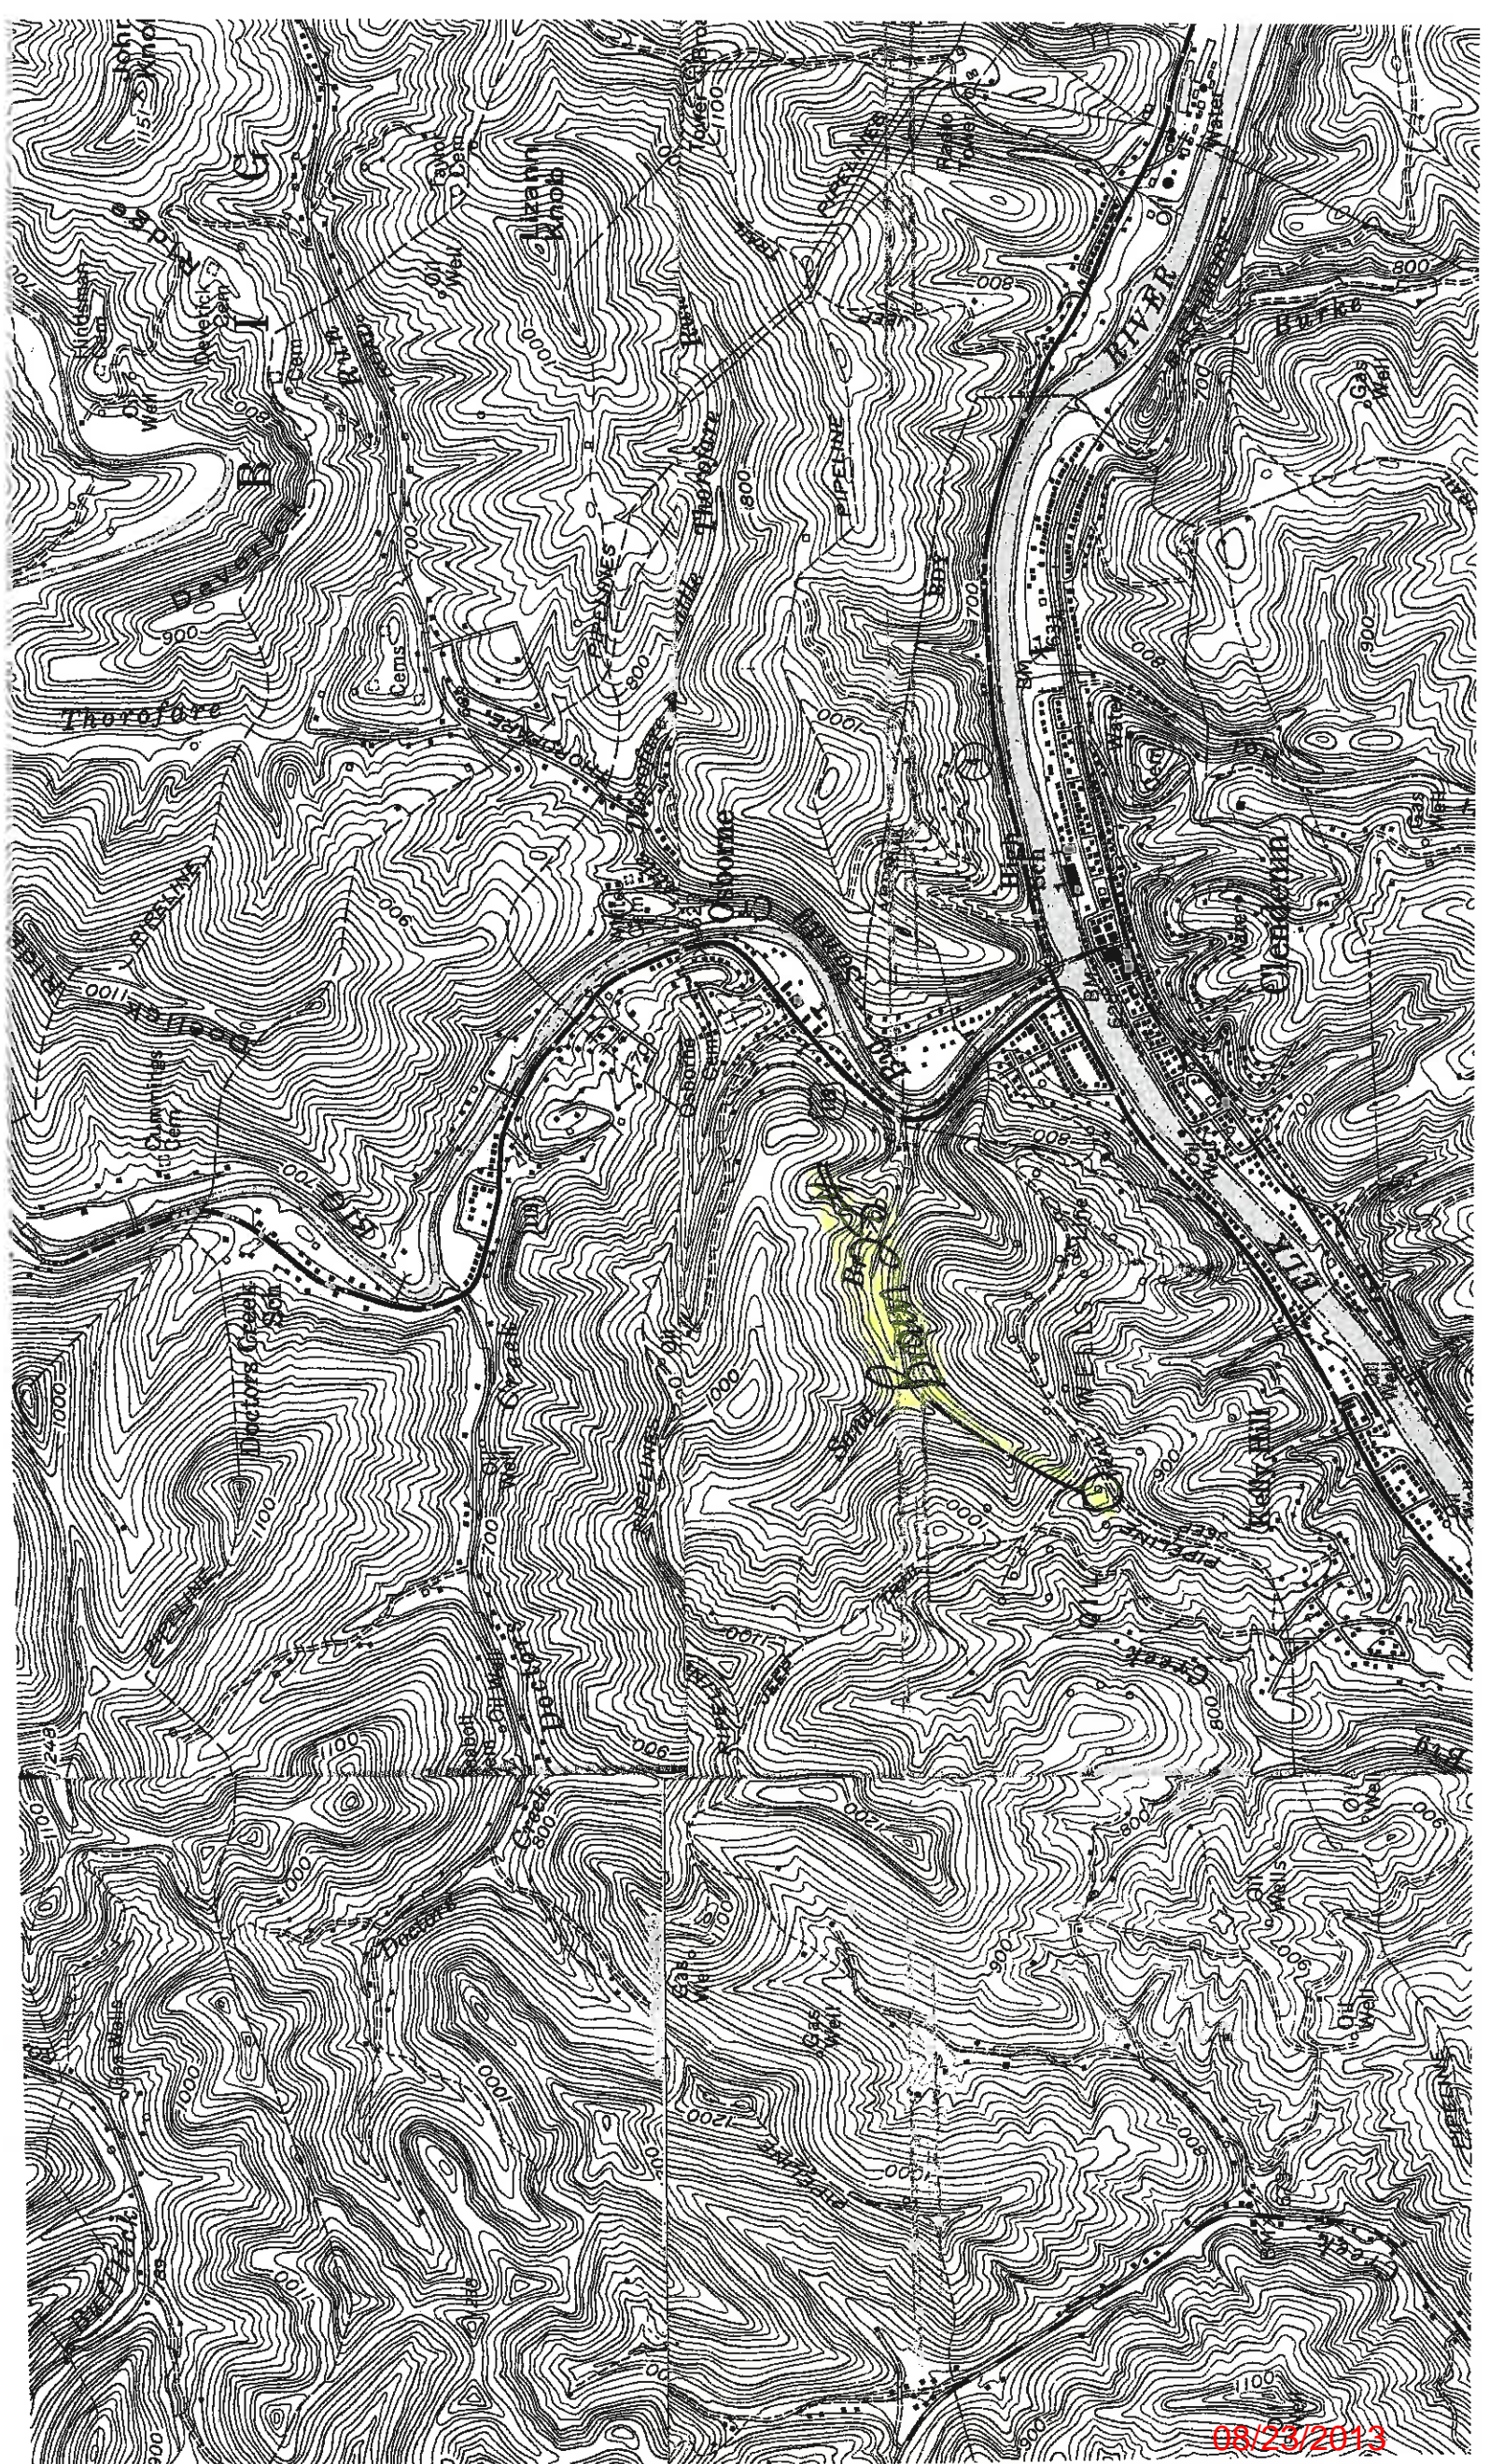

Therefore

08/23/2013