

WW-7
8-30-06



West Virginia Department of Environmental Protection
Office of Oil and Gas

WELL LOCATION FORM: GPS

API: 4703906384 WELL NO.: STUMP #1

FARM NAME: I.C. AND L.C. STUMP

RESPONSIBLE PARTY NAME: UNKNOWN

COUNTY: KANAWHA DISTRICT: BIG SANDY

QUADRANGLE: CLIO 7.5'

SURFACE OWNER: PEARL & MAYFORD HUFFMAN

ROYALTY OWNER: BLUE GROUP ENERGY, INC.

UTM GPS NORTHING: 4260990

UTM GPS EASTING: 468280 GPS ELEVATION: 989' 915'

The Responsible Party named above has chosen to submit GPS coordinates in lieu of preparing a new well location plat for a plugging permit or assigned API number on the above well. The Office of Oil and Gas will not accept GPS coordinates that do not meet the following requirements:


1. Datum: NAD 1983, Zone: 17 North, Coordinate Units: meters, Altitude: height above mean sea level (MSL) – meters.
2. Accuracy to Datum – 3.05 meters
3. Data Collection Method:

Survey grade GPS : Post Processed Differential
Real-Time Differential

Mapping Grade GPS : Post Processed Differential
Real-Time Differential

4. Letter size copy of the topography map showing the well location.

I the undersigned, hereby certify this data is correct to the best of my knowledge and belief and shows all the information required by law and the regulations issued and prescribed by the Office of Oil and Gas.

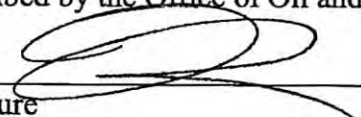
Signature

PRESIDENT - CUNNINGHAM ENERGY, LLC

Title

9/2/2016

Date


10/07/2016

Received

SEP - 7 2016

Office of Oil and Gas
WV Dept. of Environmental Protection

CUNNINGHAM ENERGY, LLC. Stump #1

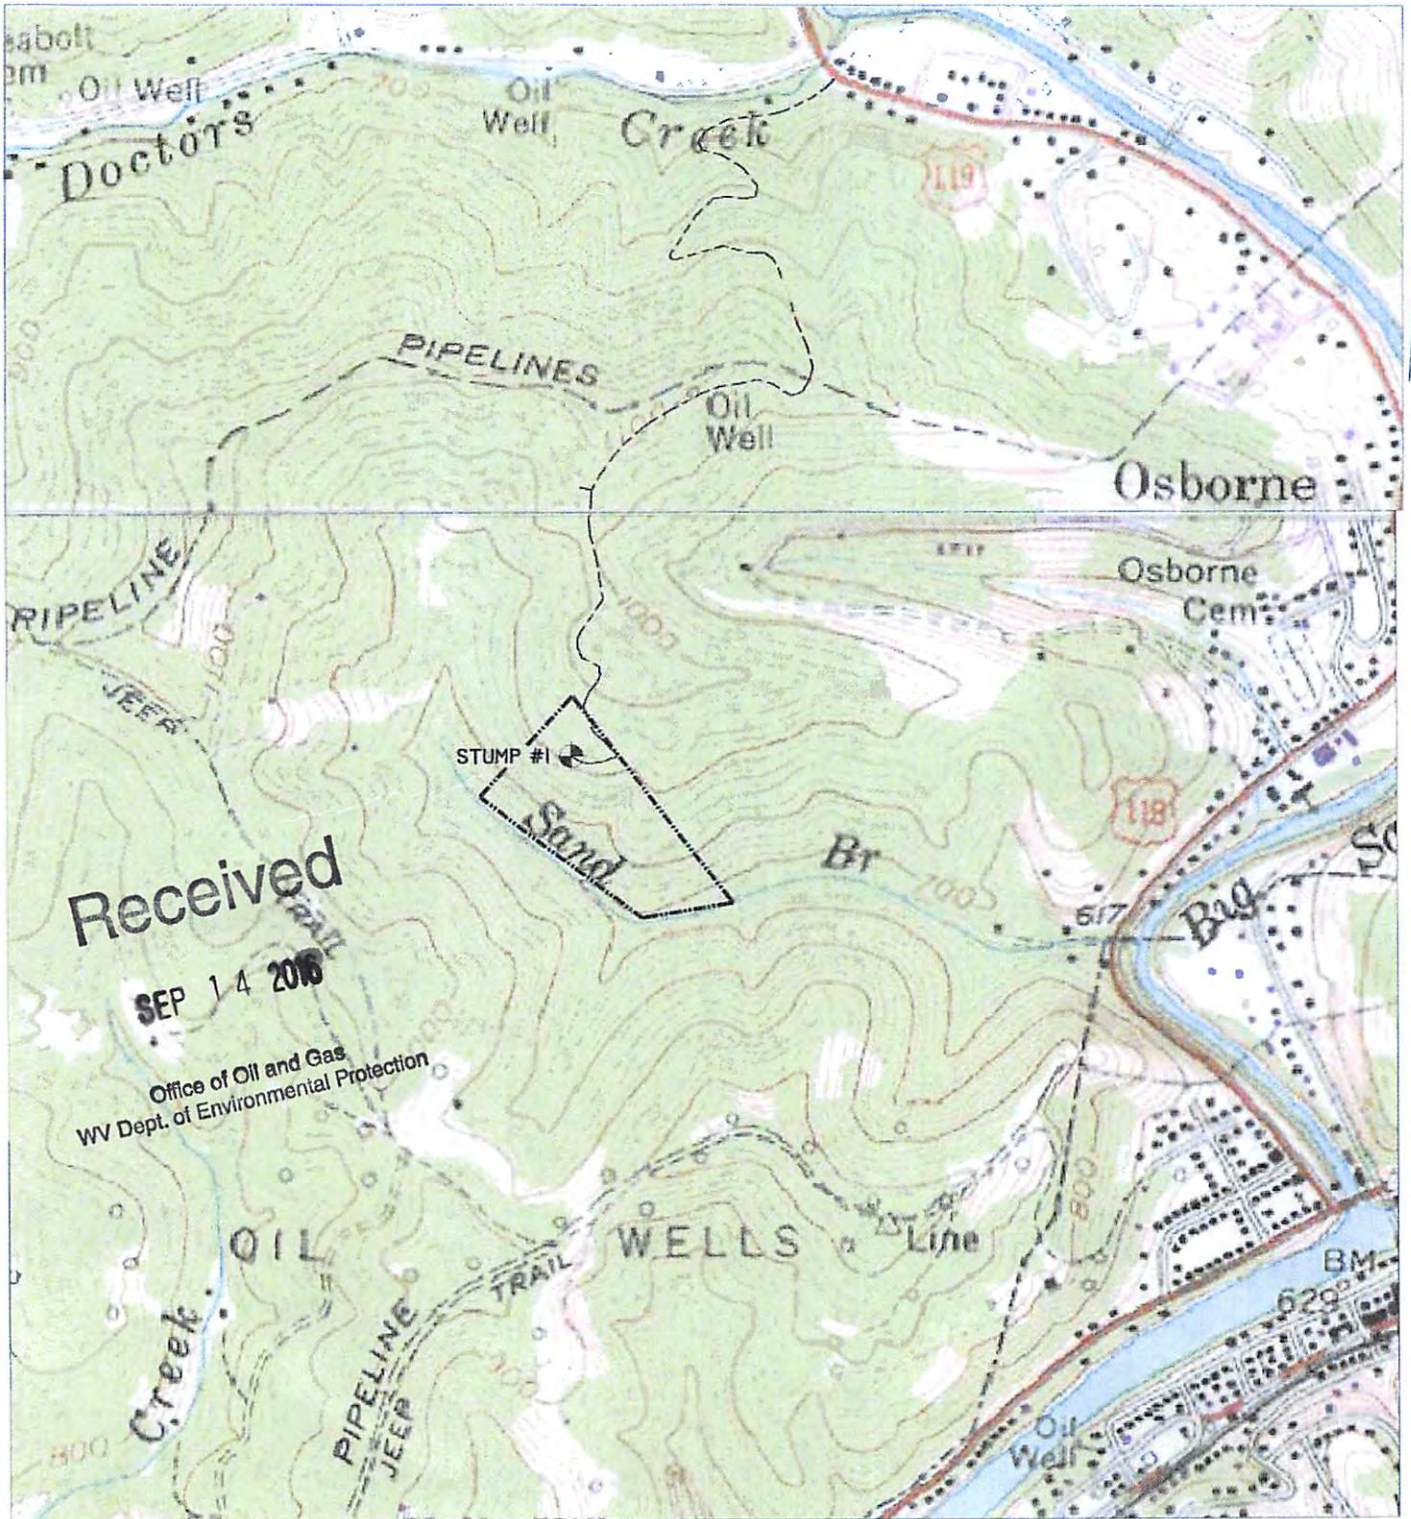

NORTH

HUPP Surveying & Mapping

P.O. BOX 647 GRANTSVILLE, WV 26147
PH: (304)354-7035 E-MAIL: hupp@frontiernet.net

1" = 1000'
Clendenin Quad

Cunningham Energy, LLC.
3230 Pennsylvania Ave.
Charleston, WV 25302

10/07/2016