

#### west virginia department of environmental protection

Office of Oil and Gas 601 57th Street, S.E. Charleston, WV 25304 (304) 926-0450 fax: (304) 926-0452

Harold D. Ward, Cabinet Secretary www.dep.wv.gov

# Monday, April 1, 2024 PERMIT MODIFICATION APPROVAL Horizontal / New Drill

COLUMBIA GAS TRANSMISSION, LLC 1700 MACCORKLE AVENUE SE

CHARLESTON, WV 25314

Re: Permit Modification Approval for COCO B / 12643

47-039-06401-00-00

SUBSURFACE CHANGES TO INCLUDE UPDATED CASING POINTS, GEOLOGIC PROGNOSIS AND DIRECTIONAL DRILL PROFILES.

#### COLUMBIA GAS TRANSMISSION, LLC

The Office of Oil and Gas has reviewed the attached permit modification for the above referenced permit. The attached modification has been approved and well work may begin. Please be reminded that the oil and gas inspector is to be notified twenty-four (24) hours before permitted well work is commenced.

If there are any questions, please feel free to contact me at (304) 926-0450.

James A. Martin

Chief

Operator's Well Number: COCO B / 12643

Farm Name: JAMES A. & FREDA MARIE MORTON

U.S. WELL NUMBER: 47-039-06401-00-00

Horizontal New Drill

Date Modification Issued: 4/1/2024

Promoting a healthy environment.

#### Columbia Gas Transmission, LLC

1700 MacCorkle Ave., SE, Charleston, WV, USA 25314



March 18, 2024

WV DEP – Office of Oil & Gas 601 57<sup>th</sup> Street, SE Charleston, WV 25304-2345

Enclosed please find a summary of subsurface changes to the new drill well plans for previously approved permit applications for the following Columbia Gas Transmission storage wells:

Coco B 12643 (API 47-039-06401T) Coco B 12644 (API 47-039-06402T)

Concise well plan prognosis has been expanded to include description of planned batch drilling operations and updated casing points. Geologic prognosis has been updated per new stratigraphic interpretations which has resulted in a change to the casing program and directional well profiles.

If you have questions, feel free to call.

Regards,

Maria Medvedeva

Senior Wells Engineer

Well Engineering & Technology

Columbia Gas Transmission, LLC

Mob: 304-410-4313

maria medvedeva@tcenergy.com

RECEIVED
Office of Oil & Gas

MAR 18 2024

WV Department of Environmental Protection



# 2024 Coco B New Drills

Sundry Request

RECEIVED
Office of Qil & Gas

MAR 18 2024

WV Department of Environmental Protection

### 1 Contents

Cond	cise Prognosis	1
Well	bore Diagram with Casing Design Calculations	2
3.1	Coco B 12643 (API 47-039-06401T)	2
3.2	Coco B 12644 (API 47-039-06402T)	4
Direc	CASING DIAGRAM  CASING DIAGRAM  COMPRISONS (ARI 47 039 06401T)	
	2.1 2.2 Well 3.1 3.2 Direct	Wellbore Diagram with Casing Design Calculations  3.1 Coco B 12643 (API 47-039-06401T)

RECEIVED
Office of Qil 8 Gas

MAR 18 2024

WV Department of Environmental Protection

# 2 Concise Prognosis

## 2.1 Coco B 12643 (API 47-039-06401T)

Construct access road and well pad. Install +/- 40 ft of 24" conductor pipe. Air drill 22" hole, install +/- 750 ft of 18-5/8" casing (minimum 40' below deepest known fresh water) and cement to surface. Air drill 17-1/2" hole, install +/- 2230 ft of 13-3/8" casing and cement to surface (to cover the Berea sandstone interval). Directionally air dill 12-1/4" hole, install 9-5/8" casing at +/- 5095 ft TVD / 5717 ft MD KB, 2 stage cement via cement stage tool for 500' overlap inside of the 13-3/8" casing. Stage tool to be set at 800' TVD above the Marcellus shale. Secure well.

Skid to well 12644 to drill air sections and the 8-1/2" section on fluid (see Drilling Program for Coco B 12644). Skid back to Coco B 12643 well.

Directionally drill 8-1/2" hole to casing point at the top of Oriskany sandstone, install +/- 6164 ft of 7" casing, and cement to 500' overlap into 13-3/8" casing. LD 5" and PU 4" workstring. Drill 6-1/8" borehole to +/- 10,880 ft MTD as per Geologist, leave as openhole completion. Secure well.

Skid to Coco B 12644 well to drill its 6-1/8" reservoir interval. RDMO drilling rig. Cleanout and acid stimulate reservoir section using 10,000 gallons 15 % HCl acid with Coil Tubing Unit on both wells. Reclaim.

#### 2.2 Coco B 12644 (API 47-039-06402T)

Skid from Coco B 12643 and RU. Air drill 22" hole, install +/- 750 ft of 18-5/8" casing (minimum 40' below deepest known fresh water) and cement to surface. Air drill 17-1/2" hole, install +/- 2230 ft of 13-3/8" casing and cement to surface (to cover the Berea sandstone interval). Directionally air dill 12-1/4" hole, install 9-5/8" casing at +/- 5099 ft TVD / 5850 ft MD KB, 2 stage cement via cement stage tool for 500' overlap inside of the 13-3/8" casing. Stage tool to be set at 800' TVD above the Marcellus shale. Swap over to a KCL polymer fluid system. Directionally drill 8-1/2" hole to casing point at the top of Oriskany sandstone, install +/- 6250 ft of 7" casing and cement to 500' overlap into the 13-3/8" casing. Secure well.

Skid back to well 12643 to drill the 8-1/2" and 6-1/8" sections on fluid (see Drilling Program for Coco B 12643). Secure well. Skid back to Coco B 12644 well.

Drill 6-1/8" borehole to +/- 10,090 ft MTD as per Geologist, leave as openhole completion. Secure well.

RDMO drilling rig. Cleanout and acid stimulate reservoir section using 10,000 gallons 15 % HCl acid with Coil Tubing Unit on both wells. Reclaim.

RECEIVED
Office of Oil & Gas

MAR 18 2024

WV Department of Environmental Protection

Huyw blich 13.24.24

#### **Wellbore Diagram with Casing Design Calculations** 3

Due to an updated geologic interpretation of area stratigraphy, new target casing depths have been designed for both of the new drill wells.


# 3.1 Coco B 12643 (API 47-039-06401T)

Formation	Lithology	Tops TVD KB	Base TVD KB	Comments		
Red Rock	Shale			Unstable shale, major hole issues likely		
Salt Sand	Sandstone	1019	1432	Potential Water (add soap / stiff foam)		
Red Rock	Shale			Unstable shale, major hole issues likely		
Maxton	Sandstone	1509	1541			
Little Lime	Limestone	1572	1606			
Big Lime	Limestone	1627	1667			
Big Injun	Sandstone	1674	1785	Potential Gas		
Weir	Sandstone	1871	2041	Potential Gas, Water, Oil		
Coffee	Shale	2188	2198	Potential intervals <0.43 psi/ft F.G.		
Berea	Sandstone	2198	2201	Potential intervals <0.43 psi/ft F.G.		
Lower Huron	Shale	3381	4192	Potential intervals < 0.43 psi/ft F.G.		
Marcellus	Shale	5065	5084	<0.43 psi/ft F.G.		
Onondaga	Limestone	5084	5094	Caprock		
Corniferous (Onon)	Limestone	5094	5207	Caprock		
Oriskany	Sandstone	5207	5244	Potential Gas, Storage Interval		
Landing Point	Sandstone	5217				

Casing Program							
Туре	Size (in)	Weight (ppf)	Grade	Set Depth (MD KB)	Depth Relation	Cement Top	
Surface	18-5/8	87.5	J-55 ERW R3	750	Cover FW	Surface	
Intermediate 1	13-3/8	68	J-55 ERW R3	2230	Cover Berea	Surface	
Intermediate 2	9-5/8	47	L-80 ERW R3	5717	Cover Marcellus	1730'	
Flowstring	7	26	L-80 ERW R3	6164	Oriskany Top	1730'	

Sections	Туре	Bottom	Тор	Comments	
18-5/8" Surface Csg	Cement Bond Log	Wiper plug	Surface	If no returns to surf	
13-3/8" Intermediate 1	Cement Bond Log	Wiper plug	Surface	If no returns to surf	
9-5/8" Intermediate 2	Cement Bond Log	Shoe	Surface	Tractor conveyed	
7" Flowstring Csg	Cement Bond & HRVRT Logs	Shoe	Surface	Tractor conveyed	
RECEN Office of Oi MAR 18	l & Gas	Newy	S 24-24		

WV Department of Environmental Protection

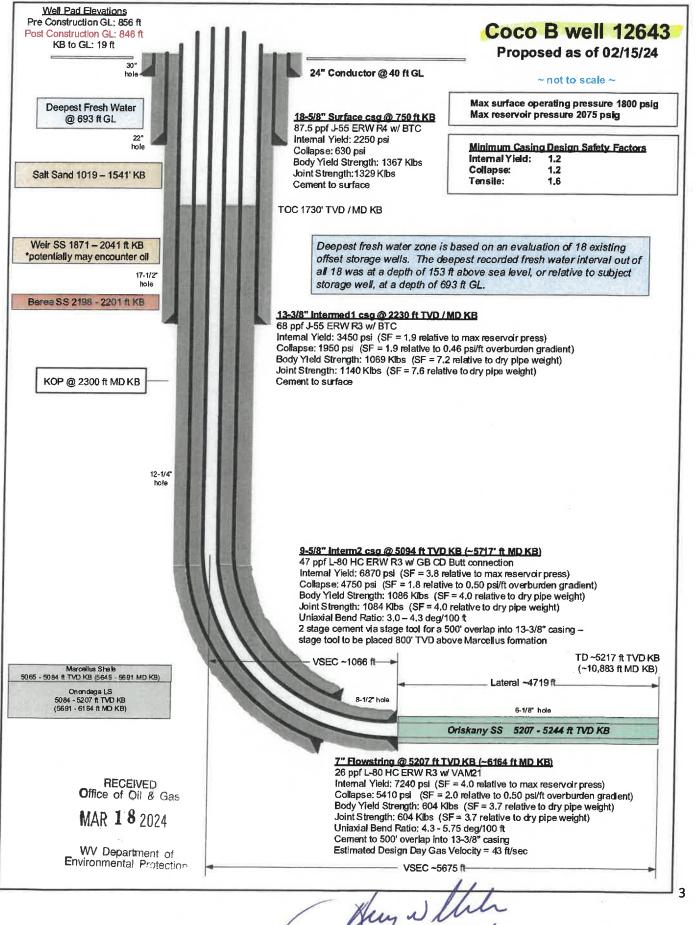

04/05/2024

#### 4 Directional Profile

# 4.1 Coco B 12643 (API 47-039-06401T)

Directional profile has been optimized to drill-by around offset storage wells in the area and for a new landing point into the Oriskany reservoir for the lateral section.

### Projected Wellbore (all coordinates are in NAD 27)

Profile:

Horizontal

Surface Location:

Lat: 38.41273

Long: -81.47216

Kick-off Point:

2300 ft KB

**Target at Landing Point:** 

Lat: 38.41676

Long: -81.46985

Landing point inclination: Landing pt entry azimuth: 90 degrees

Lateral inclination:

73.77 degrees 90 degrees

Lateral azimuth:

73.77 degrees

Vertical Section:

+/- 5675 ft

Openhole Lateral:

+/- 4720 ft

**MAXIMUM PERMITTED MEASURED DEPTH:** 

10962 ft

	Critical Points							
Critical Point	MD	INCL	AZIM	TVD	VSEC	N(+)/S(-)	E(+)/W(-)	DLS
Surface	0.00	0.00	308.56	0.00	0,00	0.00	0.00	
18.625 in Casing	750.00	0.00	307.27	750.00	0.00	0.00	0.00	0.00
Salt Sands	1019.00	0.00	307.27	1019.00	0.00	0.00	0.00	0.00
Maxton	1509.00	0.00	307.27	1509.00	0.00	0.00	0.00	0.00
Little Lime	1572.00	0.00	307.27	1572.00	0.00	0.00	0.00	0.00
Big Lime	1627.00	0.00	307.27	1627.00	0.00	0.00	0.00	0.00
Big Injun	1674.00	0.00	307.27	1674,00	0.00	0.00	0.00	0.00
Weir	1871.00	0.00	307.27	1871.00	0.00	0.00	0.00	0.00
Coffee	2188.00	0.00	307.27	2188.00	0.00	0.00	0.00	0.00
Berea	2198.00	0.00	307.27	2198,00	0.00	0.00	0.00	0.00
13.375 in Casing	2200.00	0.00	307.27	2200.00	0.00	0.00	0.00	0.00
KOP - Build @ 3° DLS	2300.00	0.00	307.27	2300.00	0.00	0.00	0.00	0.00
Hold	3446.52	34.40	307.27	3378.88	-136.52	202.20	-265,75	3.00
Lower Huron	3449.08	34.40	307.27	3381.00	-137.11	203.07	-266.90	0.00
Build & Turn @ 4.3° DLS	3743.60	34.40	307.27	3624.02	-205.13	303.82	-399.30	0.00
Marcellus	5645.29	64.92	61.09	5065.00	573.31	1203.54	-3.26	4.30
onondaga	5691.59	66.62	62.22	5084.00	615.53	1223.58	33.90	4.30
Hold 75ft	5717.29	67.57	62.84	5094.00	639.19	1234.50	54.90	4.30
9.625 in Casing	5717.29	67.57	62.84	5094.00	639.19	1234.50	54.90	4.30
Corniferous	5717.29	67.57	62.84	5094.00	639.19	1234.50	54.90	4.30
ਰੇਪਜ਼ੋਰੇ & Turn @ 5.75° DLS	5792.29	67.57	62.84	5122.62	708.50	1266.15	116.58	0.00
Driskany	6164.74	86,20	73.77	5207.00	1066.26	1398.20	452.07	5.75
fold 75ft	6164.74	86.20	73.77	5207.00	1066.26	1398.20	452.07	5.75
in Casing	6164.74	86.20	73.77	5207.00	1066.26	1398.20	452.07	5.75
Build @ 2.5° DLS	6239.74	86.20	73.77	5211.97	1139,36	1419.12	523.92	0.00
anding Point	6391.74	90.00	73.77	5217.01	1287.72	1461.57	669.76	2.50
CoCo B 12643 BHL	10883.38	90,00	73.77	5217,00	5675.01	2716.80	4982,44	0.00

RECEIVEL Office of OP 5 386

MAR 18 2024