


0 1 2 3

LATITUDE 38° 25'

LONGITUDE 81° 25'

Jos. F. Brown  
24675A

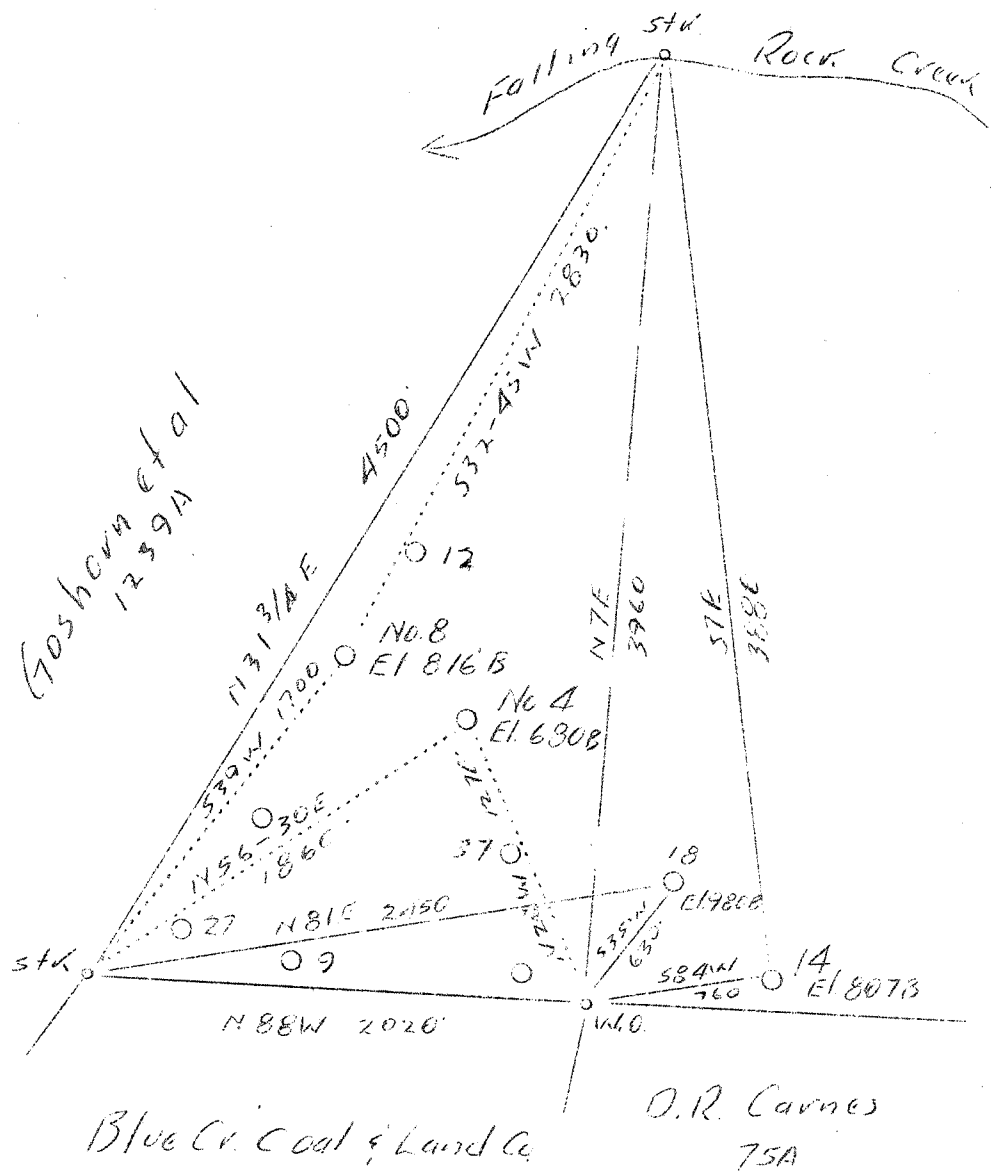

Abd. Nos 4 & 8

#4	2.17 W. 0.26 S
#8	2.35 W. 0.18 S

Company Marshall & Price  
 Address Quick, W.Va.  
 Farm Goshorn et al  
 Tract 740 Acres        Lease No.         
 Well (Farm) No. 4-8-14 & 18 Serial No.         
 Elevation (Spirit Level). (See Wells)  
 Quadrangle Clendenin C1  
 County Kanawha District Big Sandy  
 Engineer C.E. Krebs  
 Engineer's Registration No. 9  
 File No. 11,515 Drawing No.         
 Date 1-11-38 Scale 1"=800'

STATE OF WEST VIRGINIA  
 Department of Mines  
 OIL AND GAS DIVISION  
 CHARLESTON

WELL LOCATION MAP  
 File No. KAN-232A & 233A

+ Denotes location of well on United States Topographic Maps, scale 1 to 62,500, latitude and longitude lines being represented by border lines as shown.

- Denotes one inch spaces on border line of original tracing.

6-6-217