


LATITUDE 38° 25'

LONGITUDE 81° 20'

Jos. F. Brown
24675A

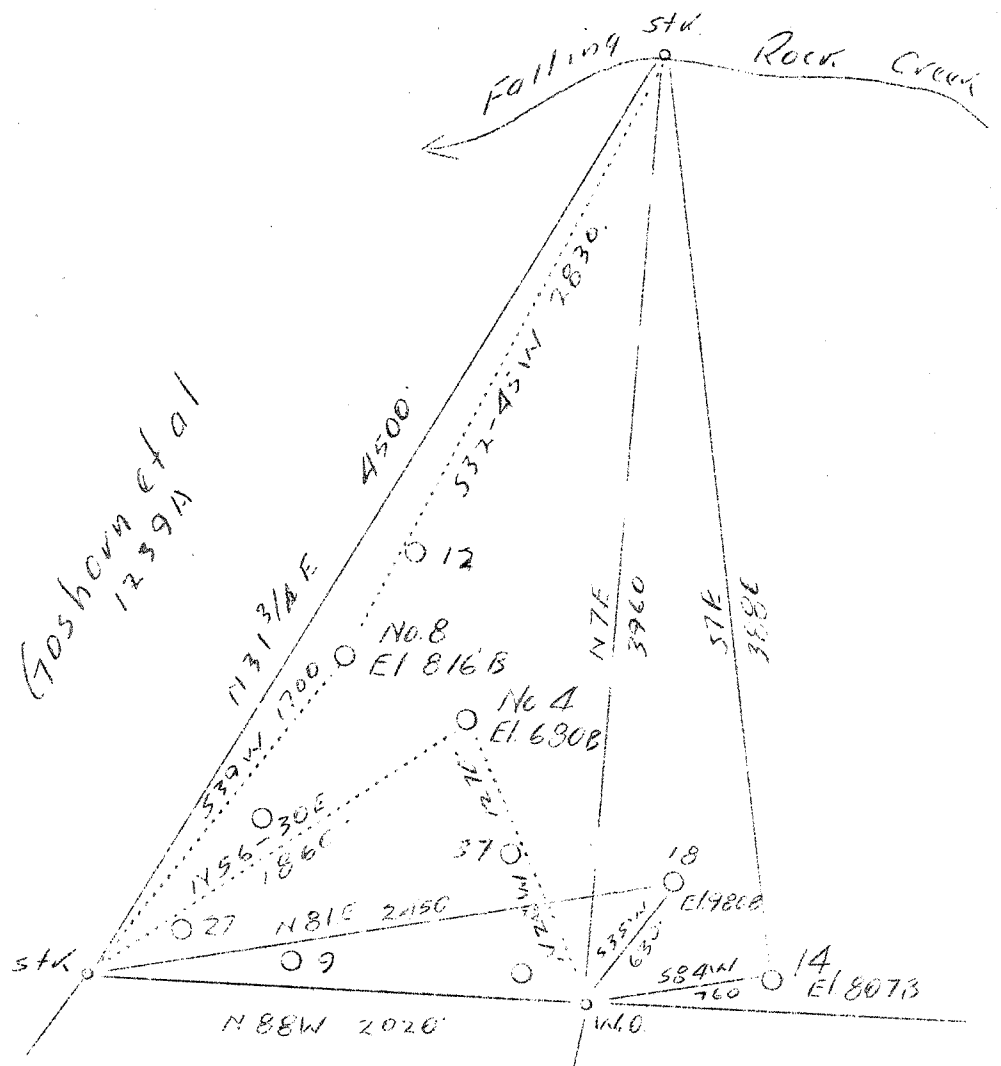

Goshorn et al
1239A

Blue Cr. Coal & Land Co

O. R. Carnes
75A

Abd. Nos 4 & 8

#4	2.17 W 0.26 S
#8	2.35 W 0.18 S

Company	Marshall & Price
Address	Quick, W.Va.
Farm	Goshorn et al
Tract	740 Acres Lease No.
Well (Farm) No.	4-8-14 & 18 Serial No.
Elevation (Spirit Level)	(See Wells)
Quadrangle	Clendenin C1
County	Kanawha District Big Sandy
Engineer	C.E. Krebs
Engineer's Registration No.	9
File No.	11.515 Drawing No.
Date	1-11-38 Scale 1"=800'

STATE OF WEST VIRGINIA
Department of Mines
OIL AND GAS DIVISION
CHARLESTON

WELL LOCATION MAP
File No. KAN-232A & 233A

+ Denotes location of well on United States Topographic Maps, scale 1 to 62,500, latitude and longitude lines being represented by border lines as shown.

— Denotes one inch spaces on border line of original tracing.

6-6-2-17