

Company	Virginian Gasoline & Oil Co.
Address	Charleston, W.Va.
Farm	J.F. Thumm Heirs
Tract	Acres 30 Lease No. 21793
Well (Farm) No.	2 & 4 Serial No. 2895
Elevation (Spirit Level)	2895-700', 2904-702'
Quadrangle	Clendenin (NW)
County	Kanawha District Elk
Engineer	G.A. Cunningham
Engineer's Registration No.	659
File No.	68-70-73 Drawing No.
Date	May 1938 Scale 1"=400'

STATE OF WEST VIRGINIA
 Department of Mines ✓
 OIL AND GAS DIVISION ✓
 CHARLESTON

WELL LOCATION MAP

File No. Kan-242-243-A

Denotes location of well on United States Topographic Maps, scale 1 to 62,500, latitude and longitude lines being represented by border lines as shown.

Denotes one inch spaces on border line of original tracing.

243A

Elk District, Kanawha County, W. Va.
 By Virginian Gasoline & Oil Co., Box 1256, Charleston, W. Va.
 On 30 acres, on Left Fork of Finch Creek.
 Elevation, 702' L.
 Surface owned by G. W. Thumm, Agent, Charleston, W. Va.
 Drilling commenced June 15, 1912; completed, July 19, 1912.
 Shot July 18, 1912, at 1772'.
 Oil, 200 bbls., 1st 24 hrs.
 8 $\frac{1}{4}$ " casing, 430' (pulled); 6-5/8", 1528'.
 Coal was encountered at 400-402'.
 Oil well. Abandonment reported to Dept. of Mines May 10, 1938.
 Record to RCT from Mrs. Griffith May 27, 1938.

	Top.	Bottom.
Slate	0	400
Coal	400	402
Slate	402	470
Sand	470	530
Slate	530	580
Sand	580	610
Slate	610	675
Sand	675	720
Slate	720	740
Lime	740	830
Slate	830	840
Salt Sand	840	1320
Lime	1320	1370
Sand	1370	1465
Little Lime	1465	1500
Slate	1500	1503
Lime	1503	1508
Slate	1508	1515
Lime	1515	1520
Pencil Cave	1520	1524
Big Lime	1524	1684
Red rock	1684	1695
Sand and slate	1695	1771
Oil sand (Weir) (break, slate and shell, 1779-1797')	1771	1779?
Break, slate and shell	1779	1797
Total depth		1797

WEST VIRGINIA DEPARTMENT OF MINES
OIL AND GAS DIVISION

648

WELL RECORD

Permit No. KAN-243-A


Oil or Gas Well Oil
(Kind)

Company Virginian Gasoline & Oil Co.
 Address Box 1256, Charleston, W. Va.
 Farm J. F. Thumm Hrs. Acres 30
 Location (waters) Left Fork, Pinch Creek
 Well No. 2904 Elev. 702
 District Elk County Kanawha
 The surface of tract is owned in fee by G.W. Thumm, Agt.
Charleston Address
 Mineral rights are owned by
 Address
 Drilling commenced June 15, 1912
 Drilling completed July 19, 1912
 Date shot July 18, 1912 Depth of shot 1772
 Open Flow /10ths Water in _____ Inch
 /10ths Merc. in _____ Inch
 Volume _____ Cu. Ft.
 Rock Pressure _____ lbs. _____ hrs.
 Oil 200 bbls., 1st 24 hrs.
 Fresh water _____ feet _____ feet
 Salt water _____ feet _____ feet

Casing and Tubing	Used in Drilling	Left in Well	Packers
Size			Kind of Packer
16			
13			
10			Size of
8 1/4	430	--	
6 5/8	1528	1528	Depth set
5 3/16			
3			Perf. top
2			Perf. bottom
Liners Used			Perf. top
			Perf. bottom

CASING CEMENTED _____ SIZE _____ No. FT. _____ Date _____
 COAL WAS ENCOUNTERED AT 200 FEET 24 INCHES
 _____ FEET _____ INCHES _____ FEET _____ INCHES
 _____ FEET _____ INCHES _____ FEET _____ INCHES

Formation	Color	Hard or Soft	Top	Bottom	Oil Gas or Water	Depth Found	Remarks
Slate			0	400			
Coal			400	402			
Slate			402	470			
Sand			470	530			
Slate			530	580			
Sand			580	610			
Slate			610	675			
Sand			675	720			
Slate			720	740			
Lime			740	830			
Slate			830	840			
Salt Sand			840	1320			
Lime			1320	1370			
Sand			1370	1465			
Little Lime			1465	1500			
Slate			1500	1503			
Lime			1503	1508			
Slate			1508	1515			
Lime			1515	1520			
Pencil Cave			1520	1524			
Big Lime			1524	1684			
Red Rock			1684	1695			
Sand & Slate			1695	1771			
Dil Sand			1771	1779			
Brk-Slate & Shell			1779	1797			
Total Depth				1797			

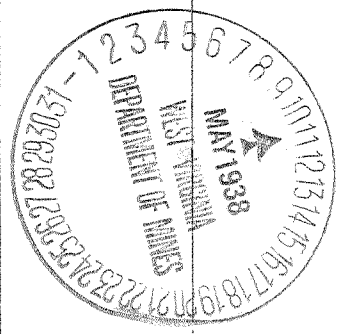

MAY 27 1938

