

4,34 W
~~1.7 of 38° 35'~~
 5.19 50' 38° 35'

F.B.D.

JUL 11 1938 ✓

Company Virginian Gasoline & Oil Co.
 Address Charleston, W. Va.
 Farm Mintie A. Oxier
 Acres 47.5
 Lease No. 12414
 Well (Farm) No. One
 Serial No. 1368
 Elevation 962.0° (Spirit Level)
 Quadrangle Walton
 County Kanawha
 District *Exp. G. A. Cunningham*
 Eng. Reg. No. 659
 File No. 72-69
 Date June 29, 1938
 Scale 1" = 660'

STATE OF WEST VIRGINIA
 Department of Mines
 OIL & GAS DIVISION
 Charleston

WELL LOCATION MAP

File No. Kan-249-A

X Denotes location of well on U. S. Topographic Maps, scale 1 to 62,500, latitude and longitude lines being represented by border lines as shown.

- Denotes one inch spaces on border line of original tracing.

Big Sandy District, Kanawha County, W. Va. 249A

By Virginian Gasoline & Oil Co., Charleston, W. Va.

On 47½ acres, on Wills Creek.

Elevation, 962.0' L.

Surface and minerals owned by Garner Dorsey et al., Clendenin, W. Va.

Drilling commenced April 17, 1924; completed, June 2, 1924.

Shot June 4, 1924, at 1920'.

Oil, 3 bbls., 1st 2½ hours.

8½" casing, 510' (pulled); 6½", 1783'.

Oil well. Abandonment reported to Dept. of Mines June 30, 1938.

Record to ROT from Mrs. Griffith August 12, 1938.

	Top.	Bottom.
Sand and slate	11	- 455
Dunkard Sand	455	- 580
Slate and shells	580	- 735
Sand	735	- 830
Slate and shells	830	- 960
Gas Sand	960	- 1020
Slate and shells	1020	- 1135
Salt Sand	1135	- 1505
Black lime	1505	- 1550
Maxton Sand	1550	- 1643
Little Lime	1643	- 1743
Slate	1743	- 1748
Lime shells	1748	- 1757
Pencil Cove	1757	- 1761
Big Lime	1761	- 1887
Big Injun Sand (gas, 1891'; oil, 1927')	1887	- 1932
Slate	1932	- 1937
Total depth		1937

W.V. No. 249-A

668

WEST VIRGINIA DEPARTMENT OF MINES
OIL AND GAS DIVISION

WELL RECORD

Permit No.

Oil or Gas Well Oil
(Kind)

Company Virginian Gasoline & Oil Company
 Address Charleston, W. Va.
 Farm Mintie Oxier Acres 47 1/2
 Location (waters) Wills Creek
 Well No. 1368 Elev. 962.0
 District Big Sandy County Kanawha
 The surface of tract is owned in fee by Garner Dorsey, et al
 Address Glendenin, W. Va.
 Mineral rights are owned by Same
 Address


Drilling commenced April 17, 1924
 Drilling completed June 2, 1924
 Date shot June 4, 1924 Depth of shot 1920
 Open Flow /10ths Water in Inch
 /10ths Merc. in Inch
 Volume Cu. Ft.
 Rock Pressure lbs. hrs.
 Oil 3 bbls., 1st 24 hrs.
 Fresh water feet feet
 Salt water feet feet

Casing and Tubing	Used in Drilling	Left in Well	Packers
Size			
16			Kind of Packer.....
13			Size of.....
10			Depth set.....
8 1/4	510	---	
6 5/8	1783	1783	
5 3/16			
3			Perf. top.....
2			Perf. bottom.....
Liners Used.....			Perf. top.....
			Perf. bottom.....

CASING CEMENTED SIZE No. FT. Date

COAL WAS ENCOUNTERED AT FEET INCHES
 FEET INCHES FEET INCHES
 FEET INCHES FEET INCHES

Formation	Color	Hard or Soft	Top	Bottom	Oil Gas or Water	Depth Found	Remarks
and & Slate			11	455			
unkard Sand			455	580			
late & Shells			580	735			
and			735	830			
late & Shells			830	960			
as Sand			960	1020			
late & Shells			1020	1135			
alt Sand			1135	1505			
lack Lime			1505	1550			
axon Sand			1550	1643			
ittle Lime			1643	1743			
late			1743	1748			
ime Shells			1748	1757			
encil Cave			1757	1761			
ig Lime			1761	1887	Gas	1891	
ig Injun			1887	1932	oil	1927	
late			1932	1937			
otal Depth				1937			

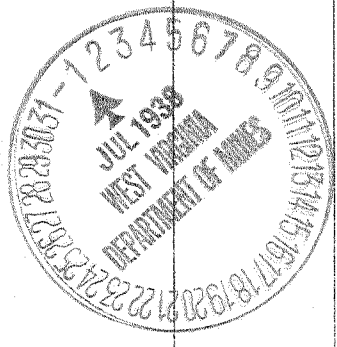

AUG 12 1938

