


LATITUDE 38° 30'

LONGITUDE 81° 25'

Note - No log available for well #3383 with use of six wells #2876 & right for admid of well #3383

#2876 Elev. 6440

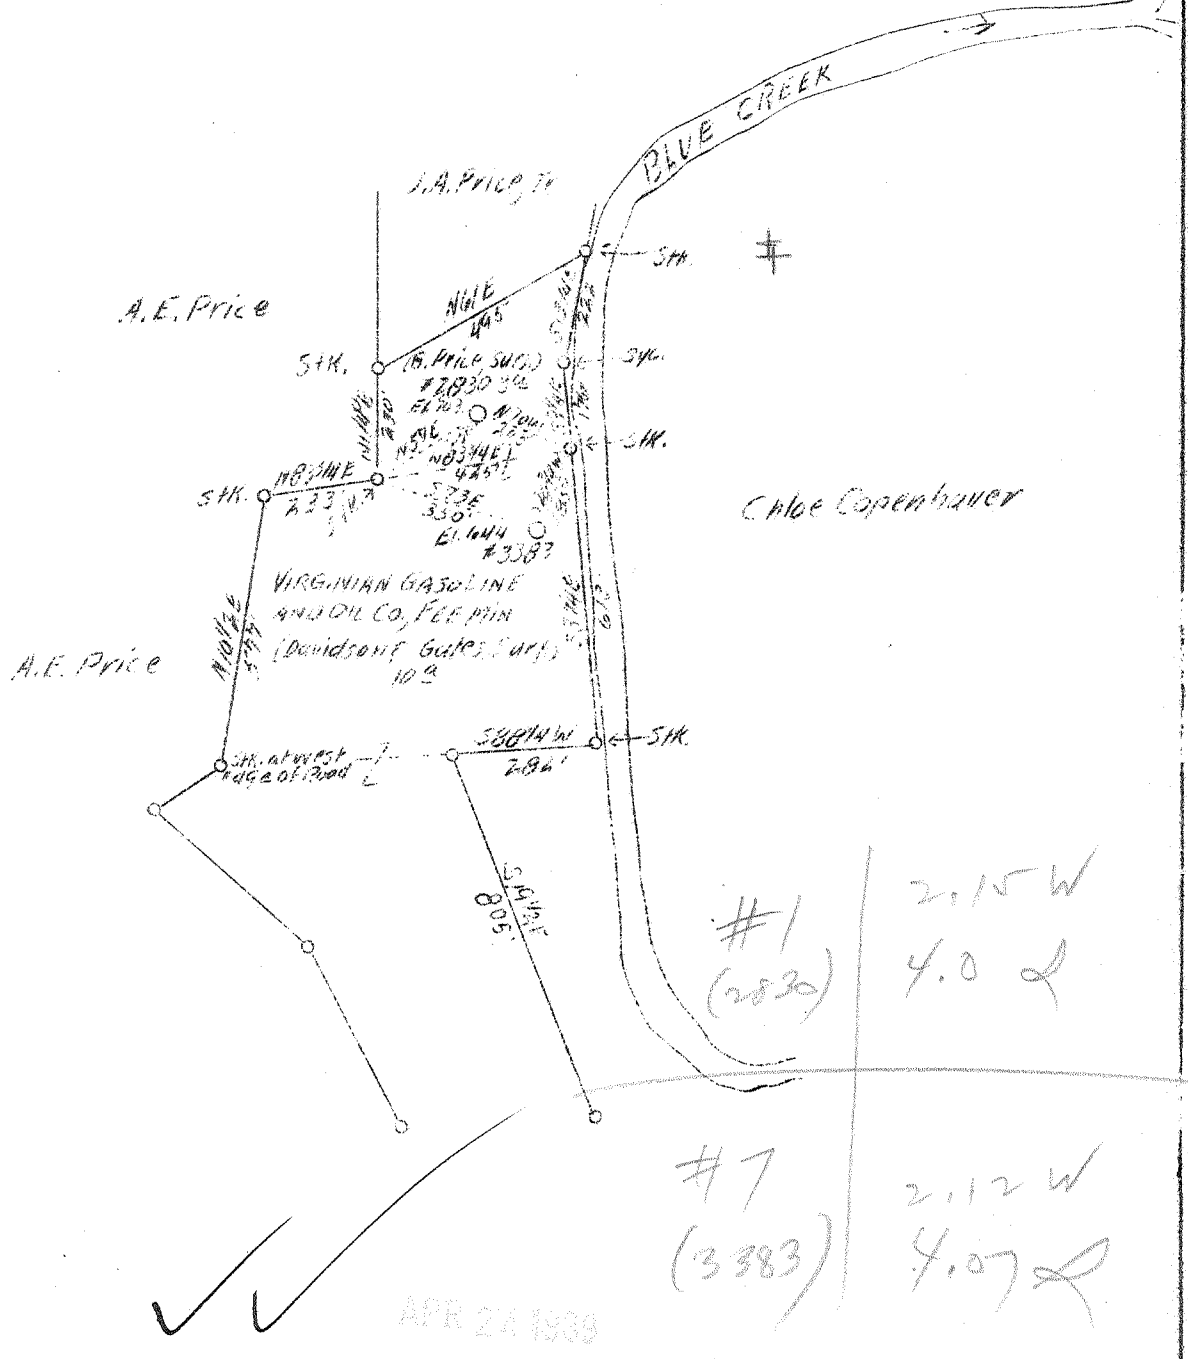

ABD

<p>Company Virginia Gasoline & Oil Co. Address Charleston, W.Va. Farm Virginia Gasoline & Oil Co. Fee Acres 3/10 Lease No. 27467 27464 Well(Farm) 1 & 7 Serial No. 2830 & 3383 EL.(S. L.) As Shown Quadrangle Clenden County Kanawha District Elk Eng. G.A.Cunningham Eng. Reg. No. 659 File No. 70 - 65 Date 4/14/39 Scale 1" - 400'</p>	<p>STATE OF WEST VIRGINIA Department of Mines OIL AND GAS DIVISION Charleston</p> <p>WELL LOCATION MAP</p> <p>File No. <u>Map. 262-263-A</u></p> <p>x Denotes location of well on U.S. Topographic Maps, scale 1 to 62,500, latitude and longitude lines being represented by border lines as shown.</p> <p>-- Denotes one inch spaces on border line of original tracing.</p>
--	---

STATE OF WEST VIRGINIA
DEPARTMENT OF MINES
OIL AND GAS DIVISION

733

WELL RECORD

AP 733-A
Permit No.

Oil or Gas Well. Oil
(Kind)

Company Virginian Gasoline & Oil Co.
Address Charleston, West Va.
Farm Davidson & Gates Acres 10
Location (waters) Blue Creek
Well No. 3383 Elev. 644.0
District Elk County Kanawha
The surface of tract is owned in fee by Davidson & Gates
Address Charleston, W.Va.
Mineral rights are owned by Virginian Gasoline & Oil Co. 5/8
Address Charleston, W.Va.
Drilling commenced No Record
Drilling completed " "
Date shot..... Depth of shot.....
Open Flow /10ths Water in..... Inch
/10ths Merc. in..... Inch
Volume..... Cu. Ft.
Rock Pressure..... lbs..... hrs.
Oil 1200..... bbls., 1st 24 hrs.
Fresh water..... feet..... feet
Salt water..... feet..... feet

Casing and Tubing	Used in Drilling	Left in Well	Packers
Size			
16			Kind of Packer.....
18			
10			Size of.....
8 1/4			
5 3/8	No Record		Depth set.....
5 3/16			
3			Perf. top.....
2			Perf. bottom.....
Liners Used.....			Perf. top.....
			Perf. bottom.....

CASING CEMENTED..... SIZE..... No. FT..... Date.....
COAL WAS ENCOUNTERED AT..... FEET..... INCHES
..... FEET..... INCHES..... FEET..... INCHES
..... FEET..... INCHES..... FEET..... INCHES

Formation	Color	Hard or Soft	Top	Bottom	Oil Gas or Water	Depth Found	Remarks
<i>Log of Well 2876</i>							
and late			145	145			
and & Lime			155	155			
late & Shells			220	220	Water @ 170'		
and late			340	340			
late			395	395			
and & Lime			410	410			
late & Shells			520	520	Water 740'		
alt Sand			770	770	" 860'		
ed Rock & Slate			1240	1240			
axon Sand			1320	1320			
late			1345	1345			
ittle Lime			1360	1360			
ig Lime			1428	1428			
late			1580	1580			
ed Rock			1610	1610			
late & Shells			1625	1625			
il Sand			1661	1661			
Total Depth			1681	1681			



