


LATITUDE 38° 20'



LONGITUDE 81° 25'

BLUE CREEK C. & L. CO.

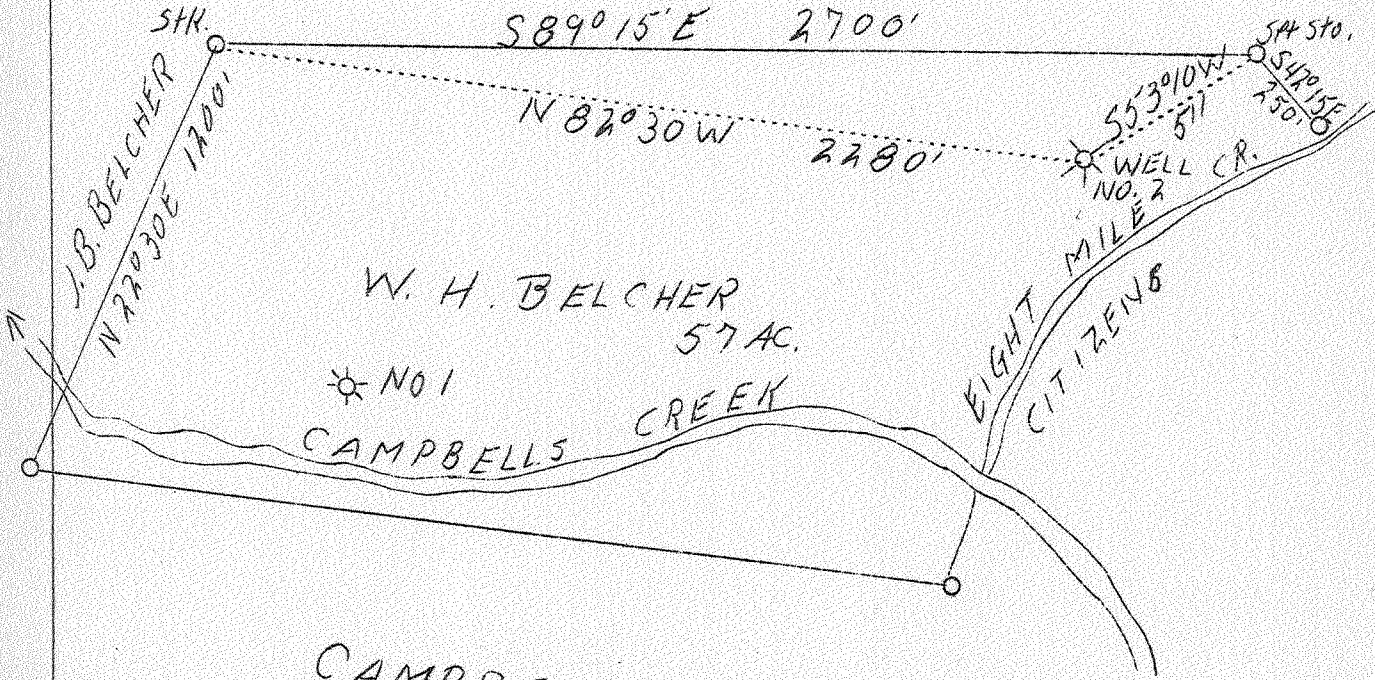

CAMPBELLS CR. COAL CO.

0.53 W
0.79 R

JUN 12 1939

ABD.

✓ COAL NOT OPERATED

Company	North Eight Prod. Co.
Address	Charleston, W. Va.
Farm	W. H. Belcher
Acres	57
Well (Farm) No.	2
Elevation (SL)	850.0 Bar.
Quadrangle	Clendenin
County	Kanawha
District	Malden
Engineer	C. E. Krebs
Eng. Reg. No.	9
File No.	11.615
Date	May 25, 1939
Scale	1" - 500'

(SW)

STATE OF WEST VIRGINIA
Department of Mines
OIL & GAS DIVISION
Charleston

WELL LOCATION MAP

File No. Kan-268-A

x Denotes location of well on U. S. Topographic Maps, scale 1 to 62,500, latitude and longitude lines being represented by border lines as shown.

- Denotes one inch spaces on border line of original tracing.

WEST VIRGINIA DEPARTMENT OF MINES
OIL AND GAS DIVISION

752

WELL RECORD

Permit No. 268A
Cleveland W.

Oil or Gas Well Gas
(Kind)

Company North Right Producing Co.
Address 804 Quarrier St., Charleston, W. Va.
Farm W. H. Belcher Acres 56
Location (waters) Campbells Creek
Well No. TWO Elev. 850
District Malden County Kanawha
The surface of tract is owned in fee by Dora Belcher
Address Putney
Mineral rights are owned by _____
Address _____
Drilling commenced Sept. 1937
Drilling completed Nov. 29, 1927
Date shot _____ Depth of shot _____
Open Flow /10ths Water in 3/10 - 2" 3/8" inch
/10ths Merc. in _____ Inch
Volume 340 M Cu. Ft.
Rock Pressure 125 lbs. 10 minutes hrs.
Oil 35% bbls., 1st 24 hrs.
Fresh water _____ feet _____ feet
Salt water _____ feet _____ feet

Casing and Tubing	Used in Drilling	Left in Well	Packers
Size			Kind of Packer
16			<u>Reater</u>
13			Size of <u>6-5/8"</u>
10	<u>140</u>	<u>140</u>	Depth set
8 1/4	<u>660</u>	<u>660</u>	<u>1343'</u>
6 5/8	<u>1231</u>	<u>1231</u>	Perf. top
5 3/16			Perf. bottom
3			Perf. top
2	<u>1500</u>	<u>1500</u>	Perf. bottom
Liners Used			Perf. top
			Perf. bottom

CASING CEMENTED _____ SIZE _____ No. FT. _____ Date _____
COAL WAS ENCOUNTERED AT 262 FEET 36 INCHES
_____ FEET _____ INCHES _____ FEET _____ INCHES
_____ FEET _____ INCHES _____ FEET _____ INCHES

Formation	Color	Hard or Soft	Top	Bottom	Oil Gas or Water	Depth Found	Remarks
Lean Sand	Yellow		0	4			
Gravel			40	50			
Blue Mud			50	80			
White Slate			80	110			
Sand			110	130			
White Sand			130	164			
Black Slate			168	200			
Line Shells			200	250			
White Slate			250	262			
Coal			262	265			
Blue Slate			265	300			
Black Slate			300	340			
Slate & Shells			340	375			
Sand			375	400			
White Lime			400	433			
Sand			433	540			
Sandy Lime			540	630			
White Sand			630	711			
Slate & Shells			711	740			
Sand			740	820			
Black Slate			820	840			
Sand			840	1080			
Slate & Shells			1080	1105			
Red Rock			1105	1120			
Maxon Sand			1120	1132			
Slate & Shells			1132	1233			
Little Lime			1233	1260			
Pencil Cave			1260	1273			
Big Lime			1273	1450	Gas	1395	
Big Injun			1450	1500	Gas	1472	
Slate & Shells			1500	1762			
Plugged Back				1500			

