

Surface: Lafe & Naomi Taylor
Quick, W. Va.
Coal: Blue Creek Coal & Land Co.
Scranton, Pa.

New Location
Drill Deeper
Abandonment X

AUG - 6 1940

1.0 W
0.3 9

Company South Penn Natural Gas Co.
 Address Parkersburg, West Va.
 Farm Mary E. Murdock
 Tract _____ Acres 8 Lease No. 62778
 Well (Farm) No. 3 Serial No. _____
 Elevation (Spirit Level) 979.35
 Quadrangle Clendenin
 County Kanawha District Elk
 Engineer E. C. Tabler
 Engineer's Registration No. _____
 File No. _____ Drawing No. _____
 Date May 27, 1940 Scale 1" = 200'

STATE OF WEST VIRGINIA
DEPARTMENT OF MINES
OIL AND GAS DIVISION
CHARLESTON

WELL LOCATION MAP
FILE NO. KAN-298A

+ Denotes location of well on United States Topographic Maps, scale 1 to 62,500, latitude and longitude lines being represented by border lines as shown.
 - Denotes one inch spaces on border line of original tracing

STATE OF WEST VIRGINIA
DEPARTMENT OF MINES
OIL AND GAS DIVISION

844

WELL RECORD

Permit No. 298-A


Oil or Gas Well OIL
(KIND)

Company <u>South Penn Natural Gas Company</u>	Casing and Tubing	Used in Drilling	Left in Well	Packers
Address <u>Union Trust Bldg. Parkersburg, W. Va.</u>	Size			
Farm <u>Mary E. Murdock</u> Acres <u>8</u>	16			Kind of Packer
Location (waters) <u>Falling Rock</u>	13			
Well No. <u>5</u> Elev. <u>979.35</u>	10			Size of
District <u>Elk</u> County <u>Kanawha</u>	8 1/4	<u>475'</u>		Depth set
The surface of tract is owned in fee by <u>Lafe & Naomi Taylor</u>	6 5/8	<u>1685'</u>		Perf. top
Address <u>Quick, W. Va.</u>	5 3/16			Perf. bottom
Mineral rights are owned by <u>Mayne Wise et al</u>	3			Perf. top
<u>914 Garden St.,</u> Address <u>Charleston, W. Va.</u>	2			Perf. bottom
Drilling commenced <u>Dec. 16, 1915</u>	Liners Used			
Drilling completed <u>Jan. 25, 1916</u>	Cond. <u>16'</u>			
Date shot <u>See Below</u> Depth of shot <u>--</u>				
Open Flow /10ths Water in <u>--</u> Inch				
/10ths Merc. in <u>--</u> Inch				
Volume <u>--</u> Cu. Ft.	CASING CEMENTED	SIZE	No. Ft.	Date
Rock Pressure <u>--</u> lbs. <u>--</u> hrs.				
Oil <u>40</u> bbls., 1st 24 hrs.	COAL WAS ENCOUNTERED AT	FEET	INCHES	
Fresh water <u>--</u> feet		FEET	INCHES	
Salt water <u>1080</u> feet <u>1300</u> feet		FEET	INCHES	

Formation	Color	Hard or Soft	Top	Bottom	Oil, Gas or Water	Depth Found	Remarks
Slate & Shells			16	995			
Salt Sand			995	1470	Water	1080	
					Water	1300	Hole full
Red Rock			1470	1500			
Slate & Shells			1500	1575			
Maxon Sand			1575	1595			
Slate			1595	1601			
Little Lime			1601	1636			
Slate			1636	1648			
Big Lime			1648	1826			
Red Rock			1826	1886			
Sand			1886	1906	Gas	1900	
Slate & Shells			1906	2013			
Weir Sand			2013	2048	Gas	2040	
					Oil	2043	
Total Depth				2050			

SHOT RECORD.

1-28-16	10 Qt.	Weir
2-20-17	20 "	"
6-21-19	30 "	"
3-31-27	40 "	"

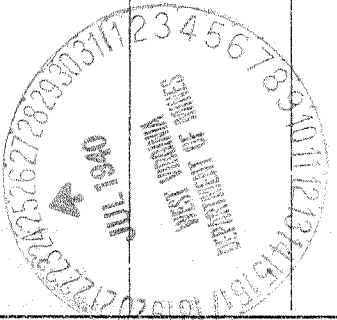

AUG 16 1940

