

New Location
 Drill Deeper
 Abandonment

OAKLAND DIVISION

AUG 13 1940

0.09 W
5.79 Q

Company WEST VIRGINIA GAS CORPORATION
 Address 401 UNION BLDG., CHARLESTON, W.VA.
 Farm SLACK HEIRS
 Tract _____ Acres 85.5 Lease No. WV 184
 Well (Farm) No. TWO Serial No. 0-8
 Elevation (Spirit Level) 1148.5
 Quadrangle KENNA SE
 County KANAWHA District ELK
 Engineer L.B. DORSEY
 Engineer's Registration No. 402
 File No. 150 Drawing No. R.O. 194
 Date JULY 30, 1940 Scale 1 INCH = 400 FEET

STATE OF WEST VIRGINIA
 DEPARTMENT OF MINES
 OIL AND GAS DIVISION
 CHARLESTON

WELL LOCATION MAP
 FILE NO. KAN-301A

+ Denotes location of well on United States Topographic Maps, scale 1 to 62,500, latitude and longitude lines being represented by border lines as shown.
 - Denotes one inch spaces on border line of original tracing.

STATE OF WEST VIRGINIA
DEPARTMENT OF MINES
OIL AND GAS DIVISION

846

WELL RECORD

AP
Permit No. 301-A


Oil or Gas Well Gas
(KIND)

Company WEST VIRGINIA GAS CORPORATION
 Address Box 404, Charleston, West Virginia
 Farm Slack Hairs Acres 88
 Location (waters) Wolf Run
 Well No. 0-8 (2) Elev. 10908
 District Elk County Kanawha
 The surface of tract is owned in fee by Slack Hairs
 Address _____
 Mineral rights are owned by Slack Hairs
 Address _____
 Drilling commenced 11-23-25
 Drilling completed 1-14-26
 Date shot _____ Depth of shot _____
 Open Flow 12 /10ths Water in _____ Inch
12 /10ths Merc. in 2" Inch
 Volume 559,000 Cu. Ft.
 Rock Pressure 380 lbs _____ hrs.
 Oil _____ bbls., 1st 24 hrs.
 Fresh water 1500 feet _____ feet
 Salt water _____ feet _____ feet

Casing and Tubing	Used in Drilling	Left in Well	Packers
Size			
16			Kind of Packer <u>Spang</u>
13			
10			Size of <u>3" x 6-5/8"</u>
8 1/4		<u>209</u>	
6 1/2		<u>1882</u>	Depth set <u>1935</u>
5 3/16			
3		<u>2035</u>	Perf. top _____
2			Perf. bottom _____
Liners Used			Perf. top _____
			Perf. bottom _____

CASING CEMENTED _____ SIZE _____ No. Ft. _____ Date _____
 COAL WAS ENCOUNTERED AT _____ FEET _____ INCHES
 _____ FEET _____ INCHES FEET _____ INCHES
 _____ FEET _____ INCHES FEET _____ INCHES

Formation	Color	Hard or Soft	Top	Bottom	Oil, Gas or Water	Depth Found	Remarks
Soil			00	20			
Red Rock			20	60			
Sand			60	80			
Slate			80	140			
Sand			140	170			
Red Rock			170	260			
Sand			260	300			
Slate			300	360			
Sand			360	400			
Lime			400	645			
Sand-Little	Dunkard		645	710			
Slate			710	725			
Lime			725	900			
Slate			900	960			
Sand			960	1020			
Lime			1020	1100			
Sand			1100	1160			
Slate			1160	1280			
Black Sand			1280	1320			
Lime			1320	1355			
Salt Sand			1355	1778			
Lime			1778	1800			
Marion Sand			1800	1832			
Little Lime			1832	1866			
Pencil Cave			1866	1872			
Big Lime			1872	2019			
Big Injun			2019	2035 1/2			

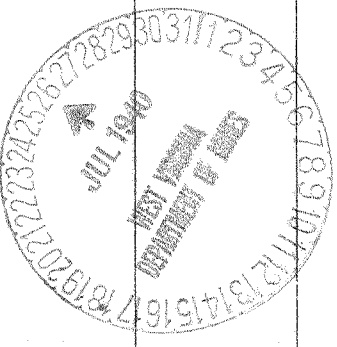

AUG 19 1940

