

New Location
 Drill Deeper
 Abandonment OAKLAND DIVISION

Company WEST VIRGINIA GAS CORPORATION
 Address 401 UNION BLDG., CHARLESTON, W.VA.
 Farm S.M. YOUNG ET AL.
 Tract Acres 36.75 Lease No. 182 WV
 Well (Farm) No. ONE Serial No. 0-1
 Elevation (Spirit Level) 896.2
 Quadrangle WALTON S W
 County KANAWHA District ELK
 Engineer Robert L Hyde
 Engineer's Registration No. 646
 File No. 150 Drawing No. R.O. 194
 Date AUGUST 8, 1940 Scale 1 INCH = 400 FEET

STATE OF WEST VIRGINIA
 DEPARTMENT OF MINES
 OIL AND GAS DIVISION
 CHARLESTON

WELL LOCATION MAP
 FILE NO. KAN-303A

+ Denotes location of well on United States Topographic Maps, scale 1 to 62,500, latitude and longitude lines being represented by border lines as shown.

- Denotes one inch spaces on border line of original tracing.

308A

Elk District, Kanawha County, W. Va.

By W. Va. Gas Corporation, Box 404, Charleston, W. Va.

On $36\frac{3}{4}$ acres, on Ruffner Branch of Little Sandy Creek.

Elevation, 896.2' L.

Drilling commenced about Oct. 1, 1924; completed about Nov. 9, 1924.

Open flow, $\frac{8}{10}$ ths Merc. in 3".

Volume, 1,118,000 cu. ft.

 $6\frac{5}{8}$ " casing, 1650'; 3" tubing, 1809'; all left in.Spang anchor packer 3 x $6\frac{5}{8}$ x 16, set at 1744'.Packer set at 1744' on 3 joints anchor with perf. (drilled $\frac{1}{2}$ " holes) joint under packer.

Approximate depth arrived at by comparison with two Withrow wells on adjoining farm. (This note opp. Salt Sand in original record).

NOTE: Only available log and record of well.

Gas well. Abandonment reported to Dept. of Mines August 7, 1940.

Record to RCT from Mrs. Griffith August 16, 1940.

	Top.	Bottom.
Salt Sand	1198	- 1416
Big Lime	1626	- 1795
Big Injun Sand (show water, 1809')	1795	- 1809
(gas, 1796-1809')		
Well shut down in good sand		
Total depth		1809

WEST VIRGINIA DEPARTMENT OF MINES
OIL AND GAS DIVISION

850

WELL RECORD

Permit No. KAN-303-A


Oil or Gas Well Gas
(Kind)

Company WEST VIRGINIA GAS CORPORATION
 Address BOX 404, CHARLESTON, W. VA.
 Farm S. M. Young Heirs Acres 36 3/4
 Location (waters) Ruffner Branch of Little Sandy Creek
 Well No. One - Serial C-1 Elev. 896.2
 District Elk County Kanawha
 The surface of tract is owned in fee by _____
 Address _____
 Mineral rights are owned by _____
 Address _____
 Drilling commenced about October 1, 1924
 Drilling completed about November 9, 1924
 Date shot _____ Depth of shot _____
 Open Flow _____ /10ths Water in _____ Inch
 _____ /10ths Merc. in 3" Inch
 Volume _____ 1,118,000 Cu. Ft.
 Rock Pressure _____ lbs. _____ hrs.
 Oil _____ bbls., 1st 24 hrs.
 Fresh water _____ feet
 Salt water _____ feet

Casing and Tubing	Used in Drilling	Left in Well	Packers
16. _____			Kind of Packer _____
13. _____			<u>Spang Anchor</u>
10. _____			Size of <u>3x6 5/8x16</u>
8 1/4 _____			
6 5/8 _____	<u>1650'</u>	<u>1650'</u>	Depth set _____
5 3/16 _____			<u>1744'</u>
3 _____	<u>1809'</u>	<u>1809'</u>	Perf. top _____
2 _____			Perf. bottom _____
Liners Used _____			Perf. top _____
			Perf. bottom _____

CASING CEMENTED _____ SIZE _____ No. FT. _____ Date _____
 COAL WAS ENCOUNTERED AT _____ FEET _____ INCHES
 _____ FEET _____ INCHES FEET _____ INCHES
 _____ FEET _____ INCHES FEET _____ INCHES

Formation	Color	Hard or Soft	Top	Bottom	Oil Gas or Water	Depth Found	Remarks
Salt Sand			1198	1416			Approximate depth arrived at by comparison with two Withrow wells on adjoining farms.
Big Lime			1626	1795			
Big Injun			1795	1809			
Show Water					1809		
Well shut down in good sand							
Gas			1796	1809			
Total Depth				1809			
<p>(Packer set at 1744' on 3 joints anchor with perf. (drilled 1/2" holes) joint under packer.)</p>							

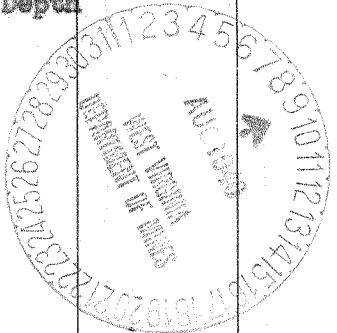

NOTE: Only available log and record of well.

AUG 16 1924

