

DAVID A. WITHROW HEIRS
52.4 a.

New Location
Drill Deeper
Abandonment OAKLAND DIVISION

AUG 21 1940

#1(0-2) 4.2 W
5.53 Q
#2(0-5) 4.3 W
5.49 Q

Company WEST VIRGINIA GAS CORPORATION
Address 401 UNION BLDG., CHARLESTON, W.VA.
Farm DAVID A. WITHROW HEIRS
Tract _____ Acres 52.4 Lease No. WV183
Well (Farm) No. ONE - TWO Serial No. 0-2:0-5
Elevation (Spirit Level) 846.6 - 807.6
Quadrangle WALTON SW
County KANAWHA District ELK
Engineer Robert S. Hyde
Engineer's Registration No. 646
File No. 150 Drawing No. R.O. 194
Date AUGUST 8, 1940 Scale 1 INCH = 400 FEET

STATE OF WEST VIRGINIA
DEPARTMENT OF MINES
OIL AND GAS DIVISION
CHARLESTON

WELL LOCATION MAP
FILE NO. KAN-304A-305A
2 1

+ Denotes location of well on United States Topographic Maps, scale 1 to 62,500, latitude and longitude lines being represented by border lines as shown.
- Denotes one inch spaces on border line of original tracing.

304A

Elk District, Kanawha County, W. Va.

By W. Va. Gas Corporation, 401 Union Bldg., Charleston, W. Va.

On 52.4 acres, on Ruffner Branch of Little Sandy Creek.

Elevation, 807.6' L.

Surface and minerals owned by Ivy M. Carte, Frame, W. Va.

Drilling commenced June 17, 1925; completed, July 22, 1925.

Open flow, 10/10" water in 3", when tubed; 49/10ths water in

2" when tubed; 1,316,000 cu. ft.; 1,266,000 cu. ft. (?)

10" casing, 34'; 6²/₈", 1565'; 3" tubing, 1712'.

Gas well. Abandonment reported to Dept. of Mines August 8, 1940.

Record to RCT from Mrs. Griffith August 16, 1940.

	Top.	Bottom.
Clay	0	34
Slate	34	80
Sand	80	530
Coal	530	534
Slate	534	640
Sand	640	710
Slate	710	800
Sand	800	835
Slate	835	935
Slate and shells	935	1005
Sand (gas, 1035')	1005	1055
Slate	1055	1115
Salt Sand gas (water, 1155', hole full)	1115	1145
Slate	1145	1150
Salt Sand	1150	1360
Lime	1360	1390
Salt Sand	1390	1440
Lime	1440	1475
Maxton Sand	1475	1512
Little Lime	1512	1542
Pencil Cave	1542	1546
Shells	1546	1553
Big Lime	1553	1638
Slate	1638	1639
Big Lime	1639	1696
Big Injun Sand (pay, 1696-1710')	1696	1712
Total depth		1712

WEST VIRGINIA DEPARTMENT OF MINES
OIL AND GAS DIVISION

WELL RECORD

849

304-A
Permit No. ~~KAN-3~~ A


Oil or Gas Well Gas
(Kind)

Company West Virginia Gas Corporation
Address 401 Union Building, Charleston, W. Va.
Farm David A. Withrow Heirs Acres 52.4
Location (waters) Ruffner Branch of Little Sandy Creek
Well No. 2 - Serial No. 8 Elev. 807.8
District Elk County Kanawha
The surface of tract is owned in fee by Ivy M. Carte Address Frame, W. Va.
Mineral rights are owned by Ivy M. Carte Address Frame, W. Va.
Drilling commenced June 17, 1928
Drilling completed July 22, 1928
Date shot _____ Depth of shot _____
Open Flow 10 /10ths Water in _____ Inch
49/10 /10ths Merc. in 5 3/8 when tubed _____ Inch
Volume 1,818,000 Cu. Ft.
1,200,000
Rock Pressure _____ lbs. _____ hrs.
Oil _____ bbls., 1st 24 hrs.
Fresh water _____ feet _____ feet
Salt water _____ feet _____ feet

Casing and Tubing	Used in Drilling	Left in Well	Packers
16.			Kind of Packer
13.			
10.	34'	34'	Size of
8 1/4			
6 5/8	1685'	1685	Depth set
5 3/16			
3.	1712	1712	Perf. top
2.			Perf. bottom
Liners Used			Perf. top
			Perf. bottom

CASING CEMENTED _____ SIZE _____ No. FT. _____ Date _____
COAL WAS ENCOUNTERED AT _____ FEET _____ INCHES
_____ FEET _____ INCHES _____ FEET _____ INCHES
_____ FEET _____ INCHES _____ FEET _____ INCHES

Formation	Color	Hard or Soft	Top	Bottom	Oil Gas or Water	Depth Found	Remarks
Clay			00	34			
Slate			34	80			
Sand			80	530			
COAL			530	534			
Slate			534	640			
Sand			640	710			
Slate			710	800			
Sand			800	835			
Slate			835	935			
Slate & Shells			935	1005			
Sand			1005	1055			
Slate			1055	1115			
Salt Sand			1115	1146	Gas	1035	
Slate			1146	1150			
Sand, Salt			1150	1360	Water	1155	Hole full
Lime			1360	1390			
Sand, salt			1390	1440			
Lime			1440	1475			
Sand, Maxon			1475	1512			
Little Lime			1512	1542			
Pencil Caves			1542	1546			
Shells			1546	1553			
Big Lime			1553	1638			
Slate			1638	1639			
Big Lime			1639	1696			
Big Injun			1696	1712			
PAY			1696	1710			

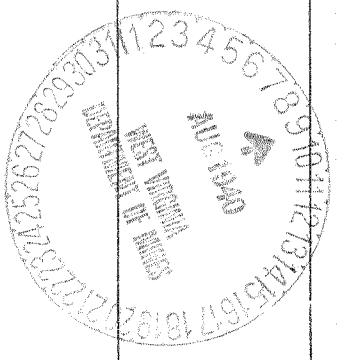

AUG 16 1940

