

New Location
 Drill Deeper
 Abandonment OAKLAND DIVISION

AUG 21 1940

#1(0-2) 4.2W
 5.53Q
 #2(0-5) 4.3W
 5.49Q

Company WEST VIRGINIA GAS CORPORATION
 Address 401 UNION BLDG., CHARLESTON, W.VA.
 Farm DAVID A. WITHROW HEIRS
 Tract Acres 52.4 Lease No. WV183
 Well (Farm) No. ONE - TWO Serial No. 0-2:0-5
 Elevation (Spirit Level) 846.6 - 807.6
 Quadrangle WALTON SW
 County KANAWHA District ELK
 Engineer Robert S. Boyd
 Engineer's Registration No. 646
 File No. 150 Drawing No. R.O. 194
 Date AUGUST 8, 1940 Scale 1 INCH = 400 FEET

STATE OF WEST VIRGINIA
 DEPARTMENT OF MINES
 OIL AND GAS DIVISION
 CHARLESTON

WELL LOCATION MAP
 FILE NO. KAN-304A-305A
 #2 #1

+ Denotes location of well on United States Topographic Maps, scale 1 to 62,500, latitude and longitude lines being represented by border lines as shown.
 - Denotes one inch spaces on border line of original tracing.

335A

Elk District, Kanawha County, W. Va.
 By W. Va. Gas Corporation, Box 1404, Charleston, W. Va.
 On 82.4 acres, on Ruffner Branch of Little Sandy Creek.
 Elevation, 846.6' l.
 Surface and minerals owned by Ivy W. Carte, Frame, W. Va.
 Drilling commenced Dec. 6, 1924; completed, Jan. 13, 1925.
 Open flow, 12/10ths Merc. in 3".
 Volume, 1,400,000 cu. ft.
 10" casing, 180'; 8 1/2" casing, 535' (pulled); 6 1/2" casing, 1615'; 3" tubing, 1756'.
 Bottom hole packer on 6 1/2". Oil Well Special Anchor gas packer set in
 Big Line 54 feet (3 joints) from bottom.
 Gas well. Abandonment reported to Dept. of Mines August 8, 1940.
 Record to ROT from Mrs. Griffith August 16, 1940.

	Top.	Bottom.
Salt Sand (water and gas, 1185'; hole full water, 1195')	1185	1395
Line	1400	1420
Maxton Sand	1420	1440
Little Line	1565	1602
Pencil Cave	1602	1610
Big Line	1610	1740
Big Injun Sand (gas, 1741-1754')	1740	1756
Total depth		1756

WEST VIRGINIA DEPARTMENT OF MINES
OIL AND GAS DIVISION

WELL RECORD

848

Permit No. KAN-305-A

Oil or Gas Well Gas
(Kind)


Company West Virginia Gas Corporation
 Address P. O. Box 404, Charleston, W. Va.
 Farm David A. Withrow Acres 52.4
 Location (waters) Ruffner Branch of Little Sandy Creek
 Well No. 1 -- Serial 0-2 Elev. 848.6
 District 31k County Kanawha
 The surface of tract is owned in fee by Ivy M. Carte Address Frano, W. Va.
 Mineral rights are owned by Ivy M. Carte Address Frano, W. Va.
 Drilling commenced Dec. 6, 1924
 Drilling completed Jan. 13, 1925
 Date shot _____ Depth of shot _____
 Open Flow 12 /10ths Water in _____ Inch
3 /10ths Merc. in _____ Inch
 Volume 1,400,000 Cu. Ft.
 Rock Pressure _____ lbs. _____ hrs.
 Oil _____ bbls., 1st 24 hrs.
 Fresh water _____ feet
 Salt water _____ feet

Casing and Tubing	Used in Drilling	Left in Well	Packers
Size			
16.			Kind of Packer * <u>Bottom Hole</u>
13.			
10.	<u>180'</u>	<u>180'</u>	Size of _____
8 1/4	<u>585'</u>	<u>Pulled</u>	
6 5/8	<u>1615'</u>	<u>1615'</u>	Depth set _____
5 3/16			
3.	<u>1756'</u>	<u>1756'</u>	Perf. top _____
2.			Perf. bottom _____
Liners Used			Perf. top _____
			Perf. bottom _____

CASING CEMENTED _____ SIZE _____ No. FT. _____ Date _____
 COAL WAS ENCOUNTERED AT _____ FEET _____ INCHES
 _____ FEET _____ INCHES _____ FEET _____ INCHES
 _____ FEET _____ INCHES _____ FEET _____ INCHES

Formation	Color	Hard or Soft	Top	Bottom	Oil Gas or Water	Depth Found	Remarks
Salt Sand			1145	1395			
				1185	Water and Gas		
				1195	Hole Full water		
Lime			1400	1420			
Maxton Sand			1420	1440			
Little Lime			1565	1602			
Pencil Cave			1602	1610			
Big Lime			1610	1740			
Big Injun			1740	1755 1/2			
			1741	1754	Gas		
Total Depth				1755 1/2			

* Bottom hole packer on 6 5/8. (3 Joints) from bottom. Oil well Special Anchor gas packer set in Big Lime 64 ft.)

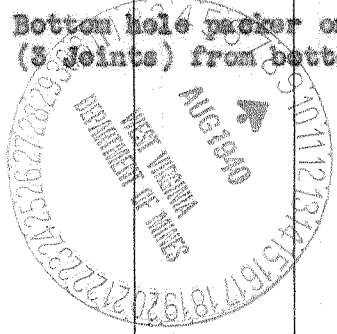

AUG 16 1940

