

New Location
 Drill Deeper
 Abandonment. X

BLUE CREEK COAL & LAND CO.
 1940

1.63 W
 0.10
 #3
 #5
 1.47 W
 0.35

Company SUMMIT O. & G. Co.
 Address CLENDENIN, W. VA.
 Farm MURDOCK HRS.
 Tract Acres 66 Lease No.
 Well (Farm) No. 3 & 5 Serial No.
 Elevation (Spirit Level) 3=1110 & 5=890
 Quadrangle CLENDENIN
 County KANAWHA District ELK
 Engineer A.E. PRICE
 Engineer's Registration No. 819
 File No. Drawing No.
 Date 8/23/40 Scale 1" = 20 P.

STATE OF WEST VIRGINIA
 DEPARTMENT OF MINES
 OIL AND GAS DIVISION
 CHARLESTON

WELL LOCATION MAP
 FILE NO. KAN-307A

+ Denotes location of well on United States Topographic Maps, scale 1 to 62,500, latitude and longitude lines being represented by border lines as shown.
 - Denotes one inch spaces on border line of original tracing.

STATE OF WEST VIRGINIA
DEPARTMENT OF MINES
OIL AND GAS DIVISION

8074

WELL RECORD

Permit No. 307A


Oil or Gas Well.....
(KIND)

Company Rex Oil and Gas Co.
Address Clendenin, West Va.
Farm Mary E. Murdock Acres 66
Location (waters) Falling Rock Creek
Well No. 5 Elev. 890
District Elk County Kanawha
The surface of tract is owned in fee by.....
Address.....
Mineral rights are owned by Murdock Hrs. c/o David
Elkview, W. Va. Address Carnes
Drilling commenced.....
Drilling completed.....
Date shot..... Depth of shot.....
Open Flow /10ths Water in..... Inch
/10ths Merc. in..... Inch
Volume..... Cu. Ft.
Rock Pressure..... lbs..... hrs.
Oil..... bbls., 1st 24 hrs.
Fresh water..... feet..... feet
Salt water..... feet..... feet

Casing and Tubing	Used in Drilling	Left in Well	Packers
Size			
16			Kind of Packer.....
13			
10			Size of.....
8 1/4	462		
6 5/8		1632	Depth set.....
5 3/16			
3			Perf. top.....
2			Perf. bottom.....
Liners Used.....			Perf. top.....
			Perf. bottom.....

CASING CEMENTED..... SIZE..... No. Ft..... Date.....
COAL WAS ENCOUNTERED AT..... FEET..... INCHES
..... FEET..... INCHES..... FEET..... INCHES
..... FEET..... INCHES..... FEET..... INCHES

Formation	Color	Hard or Soft	Top	Bottom	Oil, Gas or Water	Depth Found	Remarks
Soil			0	12			
Slate			12	17			
Mud			17	25			
Slate			25	60			
Sand			60	110			
Slate			110	145			
Sand			145	155			
Slate			155	171			
Sand			171	230			
Slate			230	238			
Sand			238	258			
Slate			258	268			
Sand			268	273			
Lime			273	293			
Sand			293	303			
Slate			303	313			
Sand			313	333			
Slate			333	346			
Sand			346	361			
Slate			361	369			
Sand			369	399			
Lime			399	424			
Sand			424	452			
Slate			452	477			
Lime			477	497			
Slate			497	525			
Lime			525	560			
Slate			560	605			
Lime			605	645			
Slate			645	670			
Lime			670	730			
Sand			730	745			
Slate			745	765			
Lime			765	785			
Slate			785	790			
Lime			790	805			
Slate			805	815			
Shale			815	880			
Salt Sand			880	1156			
Slate Brake			1156	1167			
Salt Sand			1167	1460			

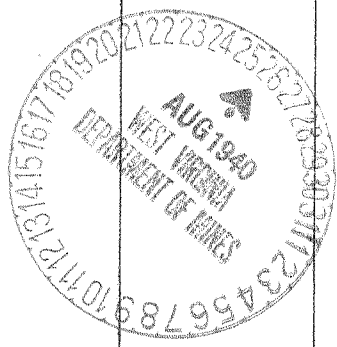

Formation	Color	Hard or Soft	Top	Bottom	Oil, Gas or Water	Depth Found	Remarks
Red Rock			1460	1487			
Lime			1487	1527			
Slate & Lime			1527	1570			
Slate			1570	1575			
Little Lime			1575	1610			
Pencil			1610	1621			
Big Lime			1621	1802			
Big Injun			1802	1852			
Sand			1852	1920			
Slate & Shale			1920	1998			
Nier Sand			1998	2022			
Sand, Shale & Slate			2022	2024			

DATE....., 194.....

APPROVED....., Owner

By.....

(Title)