

New Location   
 Drill Deeper   
 Abandonment

MAR 24 1941 B. A. Wise

2188 W  
 4.88

Company	VIRGINIAN GASOLINE & OIL CO.		
Address	CHARLESTON, W.VA.		
Farm	G.W. WHITE		
Tract	Acres	80	Lease No. 752
Well (Farm) No.	12	Serial No.	2901
Elevation (Spirit Level)	930.0		
Quadrangle	CLEDENIN		
County	KANAWHA	District	ELK
Engineer	C.		
Engineer's Registration No.	659		
File No.	70-65	Drawing No.	
Date	MAR. 14, 1941		
Scale	1" = 400'		

STATE OF WEST VIRGINIA  
 DEPARTMENT OF MINES  
 OIL AND GAS DIVISION  
 CHARLESTON

WELL LOCATION MAP  
 FILE NO. KAN-313A

+ Denotes location of well on United States Topographic Maps, scale 1 to 62,500, latitude and longitude lines being represented by border lines as shown.  
 - Denotes one inch spaces on border line of original tracing.

STATE OF WEST VIRGINIA  
DEPARTMENT OF MINES  
OIL AND GAS DIVISION

889

WELL RECORD

Ab 313-A  
Permit No. \_\_\_\_\_


Oil or Gas Well Oil  
(KIND)

Company Virginian Gasoline & Oil Company  
Address Box 1626, Charleston, West Va.  
Farm G. W. White Acres 80  
Location (waters) Left Fork of Pinch Creek  
Well No. 2901 Elev. 930.0  
District Elk County Kanawha  
The surface of tract is owned in fee by J.I. White et al  
Address Charleston, W. Va.  
Mineral rights are owned by Same  
Address \_\_\_\_\_  
Drilling commenced May 9, 1912  
Drilling completed July 6, 1912  
Date shot \_\_\_\_\_ Depth of shot 1983  
Open Flow \_\_\_\_\_ /10ths Water in \_\_\_\_\_ Inch  
\_\_\_\_\_ /10ths Merc. in \_\_\_\_\_ Inch  
Volume \_\_\_\_\_ Cu. Ft.  
Rock Pressure \_\_\_\_\_ lbs. \_\_\_\_\_ hrs.  
Oil 100 bbls., 1st 24 hrs.  
Fresh water \_\_\_\_\_ feet \_\_\_\_\_ feet  
Salt water \_\_\_\_\_ feet \_\_\_\_\_ feet

Casing and Tubing	Used in Drilling	Left in Well	Packers
Size			
16			Kind of Packer
13			
10			Size of
8 1/4	595	Pulled	
6 5/8	1758	1758	Depth set
5 3/16			
3			Perf. top
2			Perf. bottom
Liners Used			Perf. top
			Perf. bottom

CASING CEMENTED \_\_\_\_\_ SIZE \_\_\_\_\_ No. Ft. \_\_\_\_\_ Date \_\_\_\_\_  
COAL WAS ENCOUNTERED AT 550 FEET 60 INCHES  
590 FEET 60 INCHES  
\_\_\_\_\_ FEET \_\_\_\_\_ INCHES  
\_\_\_\_\_ FEET \_\_\_\_\_ INCHES

Formation	Color	Hard or Soft	Top	Bottom	Oil, Gas or Water	Depth Found	Remarks
Clay			10	10			
Lime			10	40			
Slate			40	70			
Red Rock			70	185			
Slate			185	220			
Lime			220	265			
Sand			265	280			
Slate			280	350			
Sand			350	375			
Slate			375	420			
Sand			420	480			
Lime			480	500			
Sand			500	550			
Coal			550	555			
Slate			555	590			
Coal			590	595			
Slate			595	630			
Sand			630	705			
Slate			705	750			
Sand			750	800			
Slate			800	865			
Sand			865	955			
Slate			955	990			
Salt Sand			990	1510			
Slate			1510	1520			
Sand			1520	1540			
Red Rock			1540	1550			
Slate			1550	1568			
Lime Sand			1568	1580			
Slate			1580	1595			
Lime			1595	1610			
Sand			1610	1670			
Lime			1670	1732			
Pencil Cave			1732	1735			
Big Lime			1735	1890			
Slate			1890	1910			
Red Rock			1910	1935			
Black Lime			1935	1979			
Oil Sand			1979	2008			
Total Depth				2008			

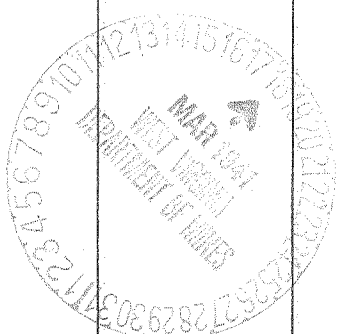

(Over)

APR 12 1941

