

New Location ☐  
 Drill Deeper ☐  
 Abandonment ☒ X

JUL - 1 1941

2.38 W  
 5.6 of

Company VIRGINIAN GASOLINE & OIL CO.  
 Address CHARLESTON, W. VA.  
 Farm C.C. LEWIS  
 Tract Acres 4164 Lease No. 17336  
 Well (Farm) No. 8 Serial No. 1703  
 Elevation (Spirit Level) 925  
 Quadrangle CLENDENIN  
 County KANAWHA District CABIN CREEK  
 Engineer G. A. Cunningham  
 Engineer's Registration No. 659  
 File No. 74-51 Drawing No.   
 Date JUNE 16, 1941 Scale 1" = 660'

STATE OF WEST VIRGINIA  
 DEPARTMENT OF MINES  
 OIL AND GAS DIVISION  
 CHARLESTON

WELL LOCATION MAP  
 FILE NO. KAN-323A

+ Denotes location of well on United States Topographic Maps, scale 1 to 62,500, latitude and longitude lines being represented by border lines as shown.

- Denotes one inch spaces on border line of original tracing

C.C. LEWIS No. 8 (1703) - VIRGINIAN GASO. & OIL CO. - KAN-323-A

STATE OF WEST VIRGINIA  
DEPARTMENT OF MINES  
OIL AND GAS DIVISION


899

WELL RECORD

Permit No. 323-A Oil or Gas Well Oil  
(KIND)

Company	VIRGINIAN GASOLINE & OIL COMPANY			Casing and Tubing	Used in Drilling	Left in Well	Packers
Address	Box 1626 Charleston, W. Va.			Size			
Farm	C. C. Lewis	Acres	4164	16			Kind of Packer
Location (waters)	Kelleys Creek			13			
Well No.	1703	Elev.	925	10	360	360	Size of
District	Cabin Creek	County	Kanawha	8 1/4	1240	1240	
The surface of tract is owned in fee by				6 5/8	1668	1668	Depth set
Address				5 3/16	1736	1736	
Mineral rights are owned by Lewis Holding Corp.				3			Perf. top
c/o R.D.Kauffelt, Sec'y, Address Ronceverte, W. Va.				2			Perf. bottom
Drilling commenced				Liners Used			Perf. top
Drilling completed July 4, 1919							Perf. bottom
Date shot No Record Depth of shot							
Open Flow /10ths Water in Inch				CASING CEMENTED SIZE No. Ft. Date			
/10ths Merc. in Inch							
Volume Cu. Ft.				COAL WAS ENCOUNTERED AT FEET INCHES			
Rock Pressure lbs. hrs.				FEET INCHES FEET INCHES			
Oil 25 bbls., 1st 24 hrs.				FEET INCHES FEET INCHES			
Fresh water feet feet							
Salt water feet feet							

Formation	Color	Hard or Soft	Top	Bottom	Oil, Gas or Water	Depth Found	Remarks
Big Line			1663	1873			
" Injun			1873	1903			
Slate & Shell			1903	1914			
Weir			1914	2094	Gas Oil "	1920 2059 2088 - 2094	Very Light
Used log of Well 2477 David Ward to plug by.							

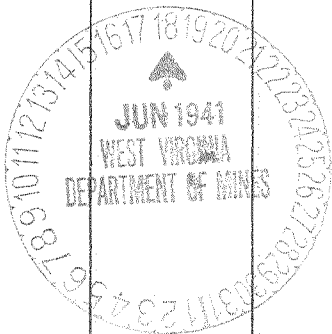

JUL 13 1941

