

New Location   
 Drill Deeper   
 Abandonment

SEP 29 1941

Company VIRGINIAN GASOLINE & OIL CO.  
 Address CHARLESTON, W.VA.  
 Farm G. ANDERSON HEIRS  
 Tract Acres 100 Lease No. 27199  
 Well (Farm) No. 6 Serial No. 3160  
 Elevation (Spirit Level) 795.7  
 Quadrangle CLENDENIN  
 County KANAWHA District ELK  
 Engineer G.A. Cunningham  
 Engineer's Registration No. 659  
 File No. 72-63 Drawing No. \_\_\_\_\_  
 Date SEPT. 5, 1941 Scale 1"=400'

STATE OF WEST VIRGINIA  
 DEPARTMENT OF MINES  
 OIL AND GAS DIVISION  
 CHARLESTON

WELL LOCATION MAP  
FILE NO. KAN-335A

+ Denotes location of well on United States Topographic Maps, scale 1 to 62,500, latitude and longitude lines being represented by border lines as shown.

- Denotes one inch spaces on border line of original tracing.

6-6-217

G. ANDERSON HEIRS, No. 6 (3160) - VIRGINIAN GASOLINE & OIL CO. - KAN-335-A

STATE OF WEST VIRGINIA  
DEPARTMENT OF MINES  
OIL AND GAS DIVISION

912

WELL RECORD

Permit No. 3357A


Oil or Gas Well OIL  
(KIND)

Company VIRGINIAN GASOLINE & OIL COMPANY  
Address Box 1626, Charleston, West Virginia  
Farm G. Anderson, Heirs Acres 100  
Location (waters) Billy Branch of Blue Creek  
Well No. 3160 Elev. 795.7  
District Elk County Kanawha  
The surface of tract is owned in fee by James Keeling et al  
Address Three Mile, W.Va.  
Mineral rights are owned by Same  
Address \_\_\_\_\_  
Drilling commenced May 25, 1915  
Drilling completed July 13, 1915  
Date shot \_\_\_\_\_ Depth of shot 1770  
Open Flow /10ths Water in \_\_\_\_\_ Inch  
/10ths Merc. in \_\_\_\_\_ Inch

Casing and Tubing	Used in Drilling	Left in Well	Packers
Size			Kind of Packer
16			
13			
10			Size of
8 1/4	512		
6 5/8	1397	1397	Depth set
5 3/16	1729	1729	
3			Perf. top
2			Perf. bottom
Liners Used			Perf. top
			Perf. bottom

Volume \_\_\_\_\_ Cu. Ft. CASING CEMENTED \_\_\_\_\_ SIZE \_\_\_\_\_ No. Ft. \_\_\_\_\_ Date \_\_\_\_\_  
Rock Pressure \_\_\_\_\_ lbs. \_\_\_\_\_ hrs.  
Oil 5 bbls., 1st 24 hrs. COAL WAS ENCOUNTERED AT 30 FEET 36 INCHES  
Fresh water 130 feet \_\_\_\_\_ FEET \_\_\_\_\_ INCHES 130 FEET 36 INCHES  
Salt water 730 feet \_\_\_\_\_ FEET \_\_\_\_\_ INCHES 504 FEET 36 INCHES

Formation	Color	Hard or Soft	Top	Bottom	Oil, Gas or Water	Depth Found	Remarks
Mud			16	16			
Line			16	30			
Coal			30	33			
Sand			33	75			
Line			75	115			
Slate			115	130	Water		Hole Full
Coal			130	133			
Sand			133	203			
Slate			203	253			
Sand			253	353			
Line			353	400			
Slate			400	435			
Sand			435	485			
Slate			485	504			
Coal			504	507			
Sand			507	537			
Slate & Shells			537	650			
Salt Sand			650	1170	Water		Hole Full
White Slate			1170	1174			
Sandy Line			1174	1196			
Slate			1196	1200			
Red Rock			1200	1233			
Slate			1233	1263			
Line			1263	1297			
Slate			1297	1306			
Maxon Sand			1306	1324			
Slate			1324	1331			
Little Line			1331	1361			
Slate			1361	1364			
Line			1364	1368			
Slate			1368	1380			
Line			1380	1387			
Pencil Cave			1387	1392			
Big Line			1392	1542	Gas		Little Gas
Slate			1542	1547			
Red Rock			1547	1587			
Slate			1587	1594	Gas		Little Gas
Sand			1594	1717	Gas		Little Gas
					Gas		Big Gas

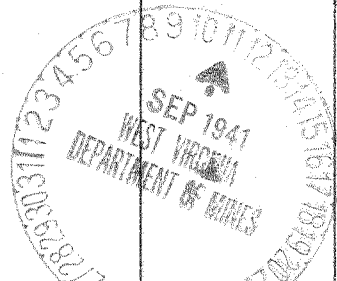

Formation	Color	Hard or Soft	Top	Bottom	Oil, Gas or Water	Depth Found	Remarks
Slate&Shells			1717	1729			
Weir Sand			1729	1806	Oil		First Oil
					Oil		2nd Oil
					Oil		Bottom Pay
Total Depth				1813			

Date September 5, 1941

APPROVED VIRGINIAN GASOLINE & OIL COMPANY, Owner

By G.A. Cunningham  
(Title)