


Latitude 38° 15' Longitude 81° 20'

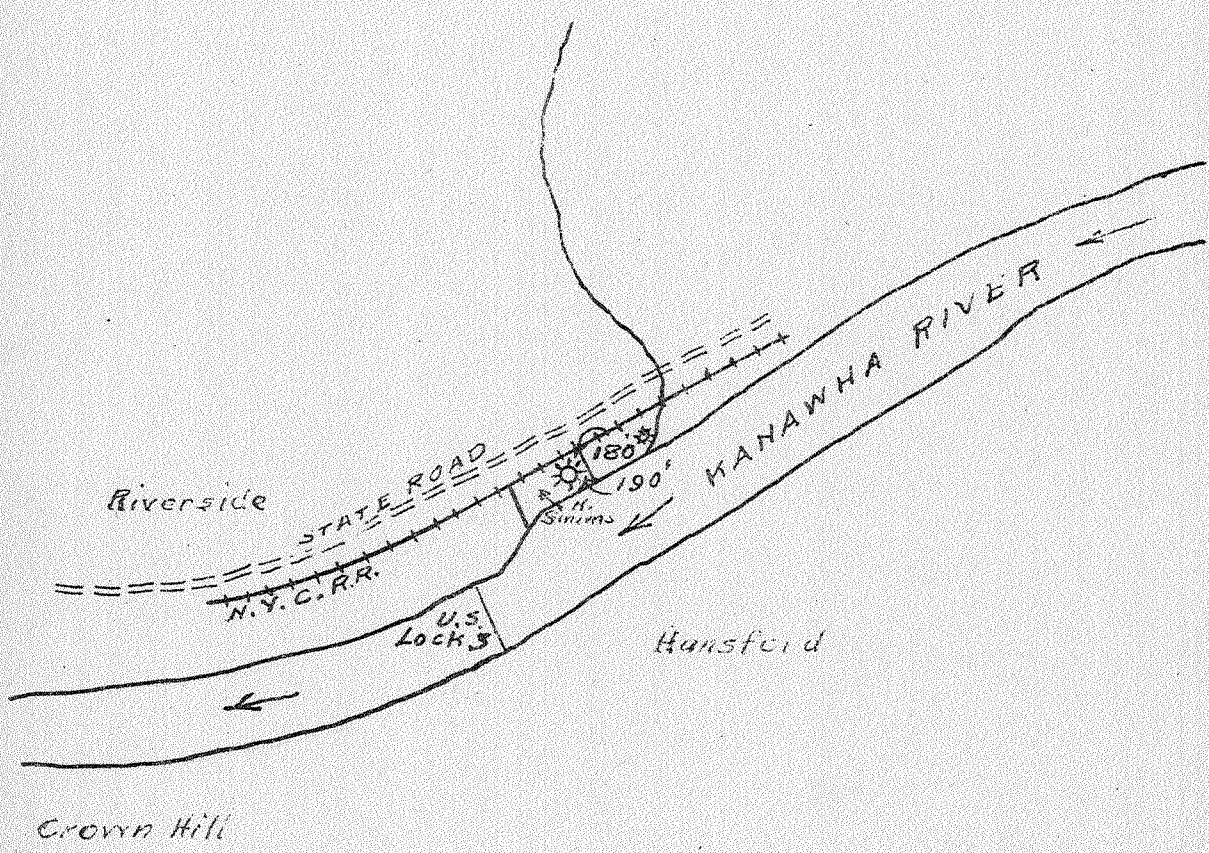

New Location   
 Drill Deeper   
 Abandonment

3.76 W  
 2.95 S

OCT 20 1941

Comp. Clarence Becker  
 Address Charleston, W. Va.  
 Farm Neilly Simms  
 Tract \_\_\_\_\_ Acres \_\_\_\_\_ Lease No. \_\_\_\_\_  
 Well (Farm) No. 1 Serial No. \_\_\_\_\_  
 Elevation (Spirit Level) 616.3  
 Quadrangle Montgomery  
 County Kanawha District Cabin Cr.  
 Engineer Geo. E. Taylor  
 Engineer's Registration No. 5  
 File No. \_\_\_\_\_ Drawing No. \_\_\_\_\_  
 Date 9-16-41 Scale 1/320" = 1"

STATE OF WEST VIRGINIA  
 DEPARTMENT OF MINES  
 OIL AND GAS DIVISION  
 CHARLESTON

WELL LOCATION MAP  
 FILE NO. KAN-336A

+ Denotes location of well on United States Topographic Maps, scale 1 to 62,500, latitude and longitude lines being represented by border lines as shown.  
 - Denotes one inch spaces on border line of original tracing.

NEILLY SIMMS NO. 1 - CLARENCE BECKER - KAN-336-A