


38° 27' 30"

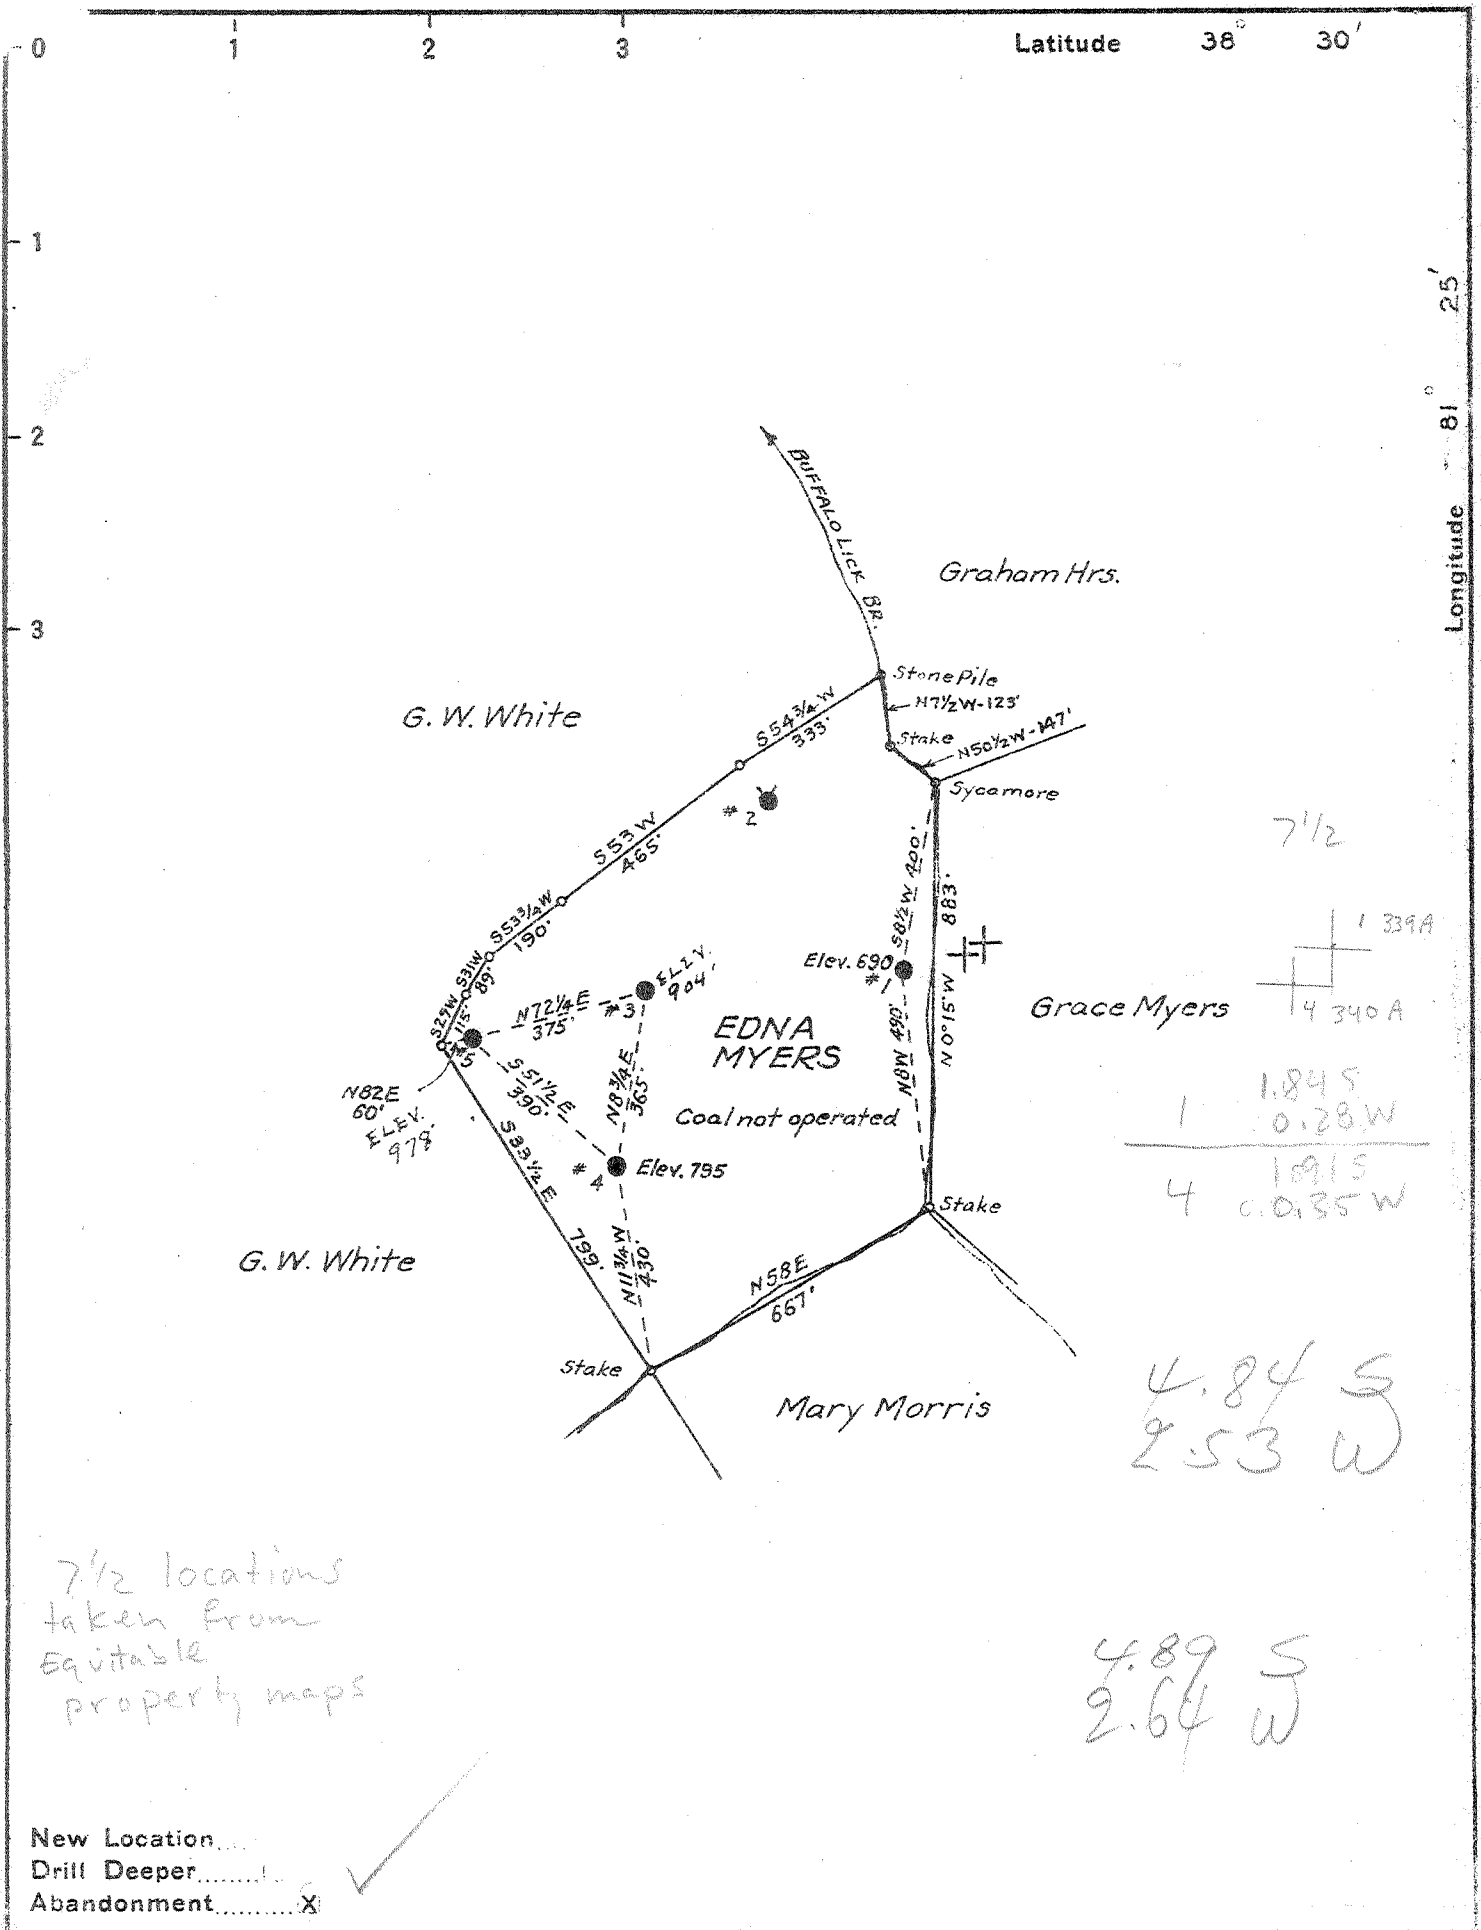

New Location.....  
 Drill Deeper.....  
 Abandonment..... X

Company W. S. EDWARDS OIL & GAS CO.  
 Address CHARLESTON, W. VA.  
 Farm EDNA MYERS  
 Tract \_\_\_\_\_ Acres 21 Lease No. \_\_\_\_\_  
 Well (Farm) No. 1 & 4 Serial No. \_\_\_\_\_  
 Elevation (BAROMETER) AS SHOWN  
 Quadrangle CLENDENIN  
 County KANAWHA District ELK  
 Engineer G. A. Cunningham  
 Engineer's Registration No. 659  
 File No. \_\_\_\_\_ Drawing No. \_\_\_\_\_  
 Date OCT. 1, 1941 Scale 1" = 400'

STATE OF WEST VIRGINIA  
 DEPARTMENT OF MINES  
 OIL AND GAS DIVISION  
 CHARLESTON

**WELL LOCATION MAP**  
 FILE NO. KAN-339A & 340A  
(3343A? 344 A-5)

+ Denotes location of well on United States Topographic Maps, scale 1 to 62,500, latitude and longitude lines being represented by border lines as shown.

- Denotes one inch spaces on border line of original tracing.

6-0-2-107