

New Location...
 Drill Deeper...
 Abandonment...

JAN - 5 1942

Company VIRGINIAN GASOLINE & OIL CO.
 Address CHARLESTON, W.VA.
 Farm C. C. LEWIS
 Tract Acres 4164 Lease No. 17336
 Well (Farm) No. 13 Serial No. 1707
 Elevation (BAROMETER) 975
 Quadrangle CLENDENIN
 County KANAWHA District CABIN CREEK
 Engineer G. A. Sumner
 Engineer's Registration No. 659
 File No. 74-51 Drawing No. _____
 Date DEC. 19, 1941 Scale 1" = 660'

STATE OF WEST VIRGINIA
 DEPARTMENT OF MINES
 OIL AND GAS DIVISION
 CHARLESTON

WELL LOCATION MAP
 FILE NO. Kan-350-A

+ Denotes location of well on United States Topographic Maps, scale 1 to 62,500, latitude and longitude lines being represented by border lines as shown.
 - Denotes one inch spaces on border line of original tracing.

C. C. LEWIS No. 13 (1707) - VIRGINIAN GASO. & OIL CO. - KAN-350-A

STATE OF WEST VIRGINIA
DEPARTMENT OF MINES
OIL AND GAS DIVISION

933

AV 350-A

WELL RECORD

Permit No.

Oil or Gas Well Oil
(KIND)


Company Virginian Gasoline & Oil Co.
 Address Box 1626, Charleston, West Va.
 Farm C.C. Lewis Acres 4164
 Location (waters) Kelleys Creek
 Well No. 1707 Elev. 975
 District Cabin Creek County Kanawha
 The surface of tract is owned in fee by _____
 Address _____
 Mineral rights are owned by Lewis Holding Corp.
R.D. Kauffelt, Secy. Address Ronceverte, W. Va.
 Drilling commenced _____
 Drilling completed September 10, 1919
 Date Shot No Record From _____ To _____
 With _____

Casing and Tubing	Used in Drilling	Left in Well	Packers
Size			
16			Kind of Packer
13			
10	474	474	Size of
8 1/4	1375	---	
6 5/8	1760	1760	Depth set
5 3/16	1867	1867	
3			Perf. top
2			Perf. bottom
Liners Used			Perf. top
			Perf. bottom

Open Flow /10ths Water in _____ Inch
 /10ths Merc. in _____ Inch
 Volume _____ Cu. Ft.
 Rock Pressure _____ lbs. _____ hrs.
 Oil 10 to 15 bbls., 1st 24 hrs.
 Fresh water No record feet _____ feet
 Salt water _____ feet _____ feet

CASING CEMENTED _____ SIZE _____ No. Ft. _____ Date _____
 COAL WAS ENCOUNTERED AT 379 FEET 60 INCHES
 _____ FEET _____ INCHES _____ FEET _____ INCHES
 _____ FEET _____ INCHES _____ FEET _____ INCHES

Formation	Color	Hard or Soft	Top	Bottom	Oil, Gas or Water	Depth Found	Remarks
Salt Sand			785	1305	Oil	2166-2172	
Big Lime			1730	1940			
Injun			1940	1975			
Slate & Shell			1975	1992			
Weir			1992	2172			
Total Depth			2172				

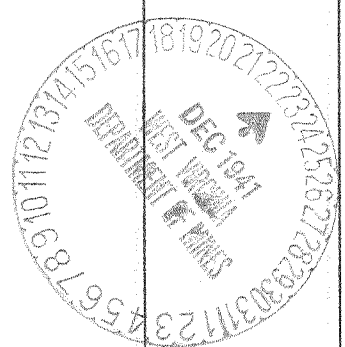

Formation	Color	Hard or Soft	Top	Bottom	Oil, Gas or Water	Depth Found	Remarks

Date December 19, 194 1

APPROVED VIRGINIAN GASOLINE & OIL CO., Owner

By J. A. Cunningham
(Title)

