


Latitude 38 20

Longitude 81 30

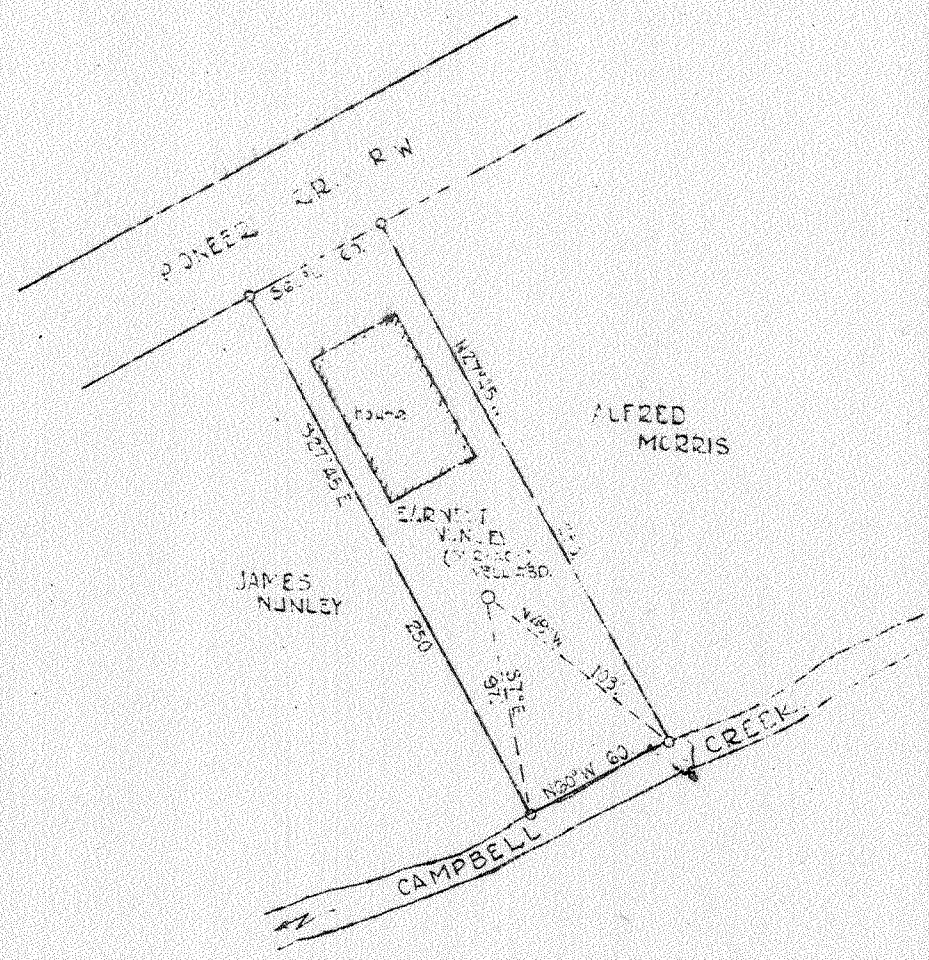

1.9 W
1.38 Q

JAN - 5 1942

New Location
Drill Deeper
Abandonment X

Company CLARENCE BECKER
 Address CHARLESTON, W. VA.
 Farm C.C. DICKINSON - MIN.
 Tract _____ Acres LOT. Lease No. _____
 Well (Farm) No. ONE Serial No. _____
 Elevation Spirit Level 624
 Quadrangle CHARLESTON
 County KANAWHA District MALDEN
 Engineer A. E. PRICE
 Engineer's Registration No. 819
 File No. _____ Drawing No. _____
 Date 10/23/41 Scale 1" = 5 POLES

STATE OF WEST VIRGINIA
DEPARTMENT OF MINES
OIL AND GAS DIVISION
CHARLESTON

WELL LOCATION MAP
FILE NO. Kan-351-A

+ Denotes location of well on United States Topographic Maps, scale 1 to 62,500, latitude and longitude lines being represented by border lines as shown.
 - Denotes one inch spaces on border line of original tracing.

57

C. C. DICKINSON NO. 1 - CLARENCE BECKER - KAN-351-A