


Latitude 38 30' Longitude 81 25'

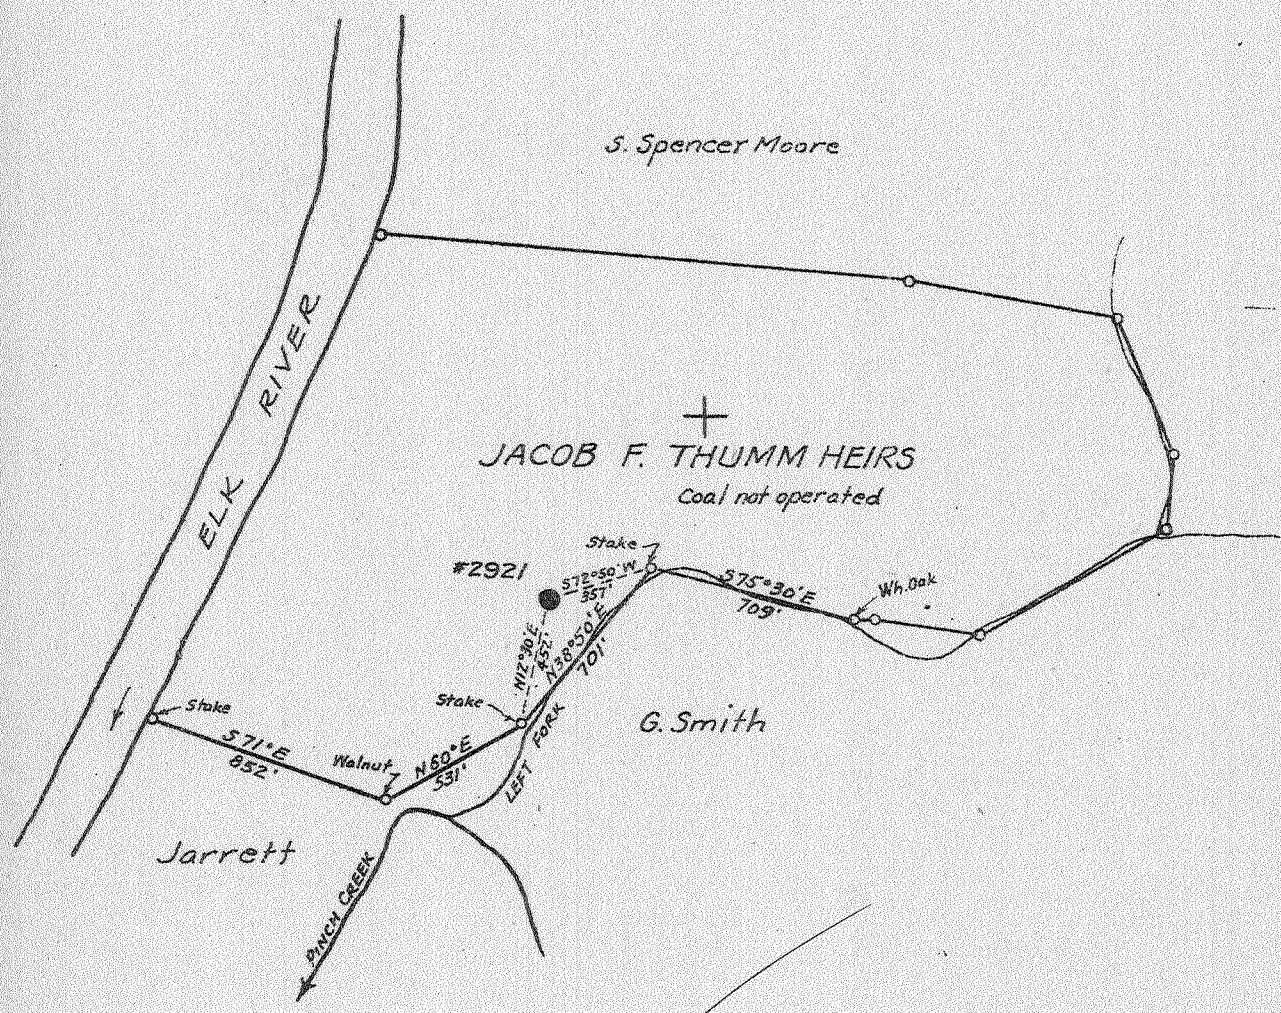

New Location
 Drill Deeper
 Abandonment IX

APR 13 1942

3.82 W
 5.43

Company VIRGINIAN GASOLINE & OIL CO.
 Address CHARLESTON, W.VA.
 Farm JACOB F. THUMM HEIRS
 Tract _____ Acres 60 Lease No. 27194
 Well (Farm) No. 5 Serial No. 2921
 Elevation (Spirit Level) 732.0
 Quadrangle CLENDENIN
 County KANAWHA District ELK
 Engineer [Signature]
 Engineer's Registration No. 659
 File No. 68-63 Drawing No. _____
 Date APRIL 3, 1942 Scale 1" = 660'

STATE OF WEST VIRGINIA
 DEPARTMENT OF MINES
 OIL AND GAS DIVISION
 CHARLESTON

WELL LOCATION MAP
 FILE NO. KAN-357-A

+ Denotes location of well on United States Topographic Maps, scale 1 to 62,500, latitude and longitude lines being represented by border lines as shown.
 - Denotes one inch spaces on border line of original tracing.

JACOB F. THUMM HEIRS, No 5 (2921) - VIRGINIAN GAS & OIL CO. - KAN-357-A

STATE OF WEST VIRGINIA
DEPARTMENT OF MINES
OIL AND GAS DIVISION

937

WELL RECORD

Permit No. 357-A

Oil or Gas Well Oil
(KIND)

Company Virginian Gasoline & Oil Company
 Address Box 1626, Charleston, W. Va.
 Farm Jacob Thumm, Hrs. Acres 95
 Location (waters) Pinch Creek
 Well No. 2921 Elev. 732 L
 District Elk County Kanawha
 The surface of tract is owned in fee by G. W. Thumm
610 - 54th. St. S. E. Address Charleston, W. Va.
 Mineral rights are owned by Same
 Address _____
 Drilling commenced June 27, 1912
 Drilling completed July 30, 1912
 Date Shot - From 1794 To _____
 With _____
 Open Flow /10ths Water in _____ Inch
/10ths Merc. in _____ Inch
 Volume _____ Cu. Ft.
 Rock Pressure _____ lbs. _____ hrs.
 Oil 200 bbls., 1st 24 hrs.
 Fresh water _____ feet _____ feet
 Salt water _____ feet _____ feet

Casing and Tubing	Used in Drilling	Left in Well	Packers
Size			
16			Kind of Packer _____
13			<u>Callanan</u>
10			Size of <u>6-5/8"x8-1/4</u>
8 1/4	<u>438</u>	<u>Pulled</u>	
6 5/8	<u>1560</u>	<u>1560</u>	Depth set <u>435</u>
5 3/16			
3			Perf. top _____
2			Perf. bottom _____
Liners Used			Perf. top _____
			Perf. bottom _____

CASING CEMENTED _____ SIZE _____ No. Ft. _____ Date _____
 COAL WAS ENCOUNTERED AT 190 FEET 48 INCHES
400 FEET 60 INCHES _____ FEET _____ INCHES
 _____ FEET _____ INCHES _____ FEET _____ INCHES

Formation	Color	Hard or Soft	Top	Bottom	Oil, Gas or Water	Depth Found	Remarks
Clay				10			
Lime			10	30			
Shale			30	45			
Slate			45	95			
Lime Shells			95	150			
Sand			150	165			
Slate			165	190			
Coal			190	194			
Lime			194	210			
Slate			210	240			
Sand			240	275			
Lime Shells			275	400			
Coal			400	405			
Lime Shells			405	465			
Sand			465	480			
Slate			480	500			
Lime			500	530			
Lime Shells			530	910			
Salt Sand			910	1365			
Slate			1365	1375			
Bastard Lime			1375	1430			
Slate			1430	1432			
Maxon Sand			1432	1500			
Little Lime			1500	1522			
Slate			1522	1530			
Lime			1530	1540			
Slate			1540	1545			
Lime Shells			1545	1550			
Pencil Cave			1550	1554			
Big Lime			1554	1690			
Keener Sand			1690	1700			
Slate			1700	1703			
Big Injun			1703	1738			
Black Shale			1738	1794			
Oil Sand			1794	1804			
Total Depth				1808			

