


W. H. Cavender Hrs.

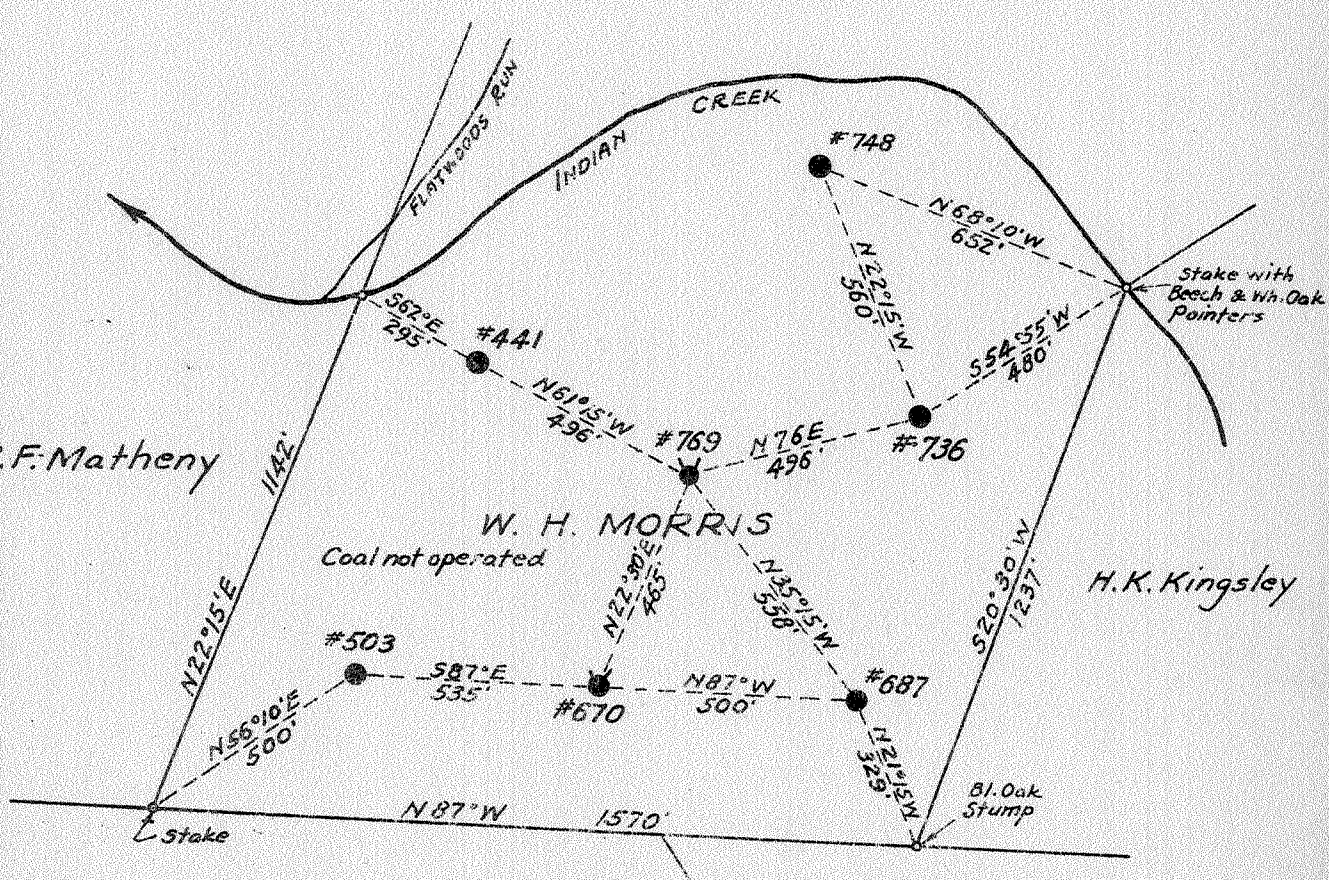

R. F. Matheny

H. K. Kingsley

Virginian Gasoline & O. Co.  
(G. J. Hunt, Surf.)

Nurma Block Coal Co.

3,47 W  
1,51 R

- New Location
- Drill Deeper
- Abandonment

MAR 15 1943

Company VIRGINIAN GASOLINE & OIL CO.  
 Address CHARLESTON, W. VA.  
 Farm W. H. MORRIS  
 Tract \_\_\_\_\_ Acres 50 Lease No. 956  
 Well (Farm) No. 5 Serial No. 736  
 Elevation (Spirit Level) 827  
 Quadrangle CLENDENIN  
 County KANAWHA District ELK  
 Engineer H. A. Cunningham  
 Engineer's Registration No. 659  
 File No. 70-81 Drawing No. \_\_\_\_\_  
 Date MAR. 5, 1943 Scale 1"=400'

STATE OF WEST VIRGINIA  
 DEPARTMENT OF MINES  
 OIL AND GAS DIVISION  
 CHARLESTON

**WELL LOCATION MAP**  
 FILE NO. KAN-376-A

+ Denotes location of well on United States Topographic Maps, scale 1 to 62,500, latitude and longitude lines being represented by border lines as shown.

- Denotes one inch spaces on border line of original tracing.

"IMPERIAL" TRACING CLOTH  
K & E CO., N. Y.