

New Location
 Drill Deeper
 Abandonment

Company	VIRGINIAN GASOLINE & OIL CO.	
Address	CHARLESTON, W.VA.	
Farm	S. SPENCER MOORE	
Tract	Acres	Lease No.
	100	779
Well (Farm) No.	Serial No.	
5	2918	
Elevation (Spirit Level)	811	
Quadrangle	CLENDENIN	
County	KANAWHA District	
Engineer	A. Cunningham	
Engineer's Registration No.	659	
File No.	70-63 Drawing No.	
Date	MAY 11, 1943 Scale: 1" = 400'	

STATE OF WEST VIRGINIA
 DEPARTMENT OF MINES
 OIL AND GAS DIVISION
 CHARLESTON

WELL LOCATION MAP
 FILE NO. KAN-382-A

+ Denotes location of well on United States Topographic Maps, scale 1 to 62,500, latitude and longitude lines being represented by border lines as shown.
 - Denotes one inch spaces on border line of original tracing.

S. SPENCER MOORE NO. 5 (2918) - VIRGINIAN GAS. & OIL CO. - KAN-382-A

STATE OF WEST VIRGINIA
DEPARTMENT OF MINES
OIL AND GAS DIVISION

949

WELL RECORD

Permit No. 382-A


Oil or Gas Well 011
(KIND)

Company Virginian Gasoline & Oil Company
Address Box 2633 Charleston, W. Va.
Farm S. S. Moore Acres 100
Location (waters) Left Fork of Pinch Creek
Well No. 2918 Elev. 811.0
District Elk County Kanawha
The surface of tract is owned in fee by _____
Address _____
Mineral rights are owned by S. S. Moore, Hrs.
Address Charleston, W. Va.
Drilling commenced July 5, 1912
Drilling completed August 3, 1912
Date Shot 10-29-13 From 1880 To 1894
With _____
Open Flow /10ths Water in _____ Inch
/10ths Merc. in _____ Inch
Volume _____ Cu. Ft.
Rock Pressure _____ lbs. _____ hrs.
Oil 400 bbls., 1st 24 hrs.
Fresh water No Record feet _____ feet
Salt water " " feet _____ feet

Casing and Tubing	Used in Drilling	Left in Well	Packers
Size			Kind of Packer
16			
13			
10			Size of
8 1/4	<u>480</u>	<u>---</u>	
6 5/8	<u>1620</u>	<u>1620</u>	Depth set
5 3/16			
3			Perf. top
2			Perf. bottom
Liners Used			Perf. top
			Perf. bottom

CASING CEMENTED _____ SIZE _____ No. Ft. _____ Date _____
COAL WAS ENCOUNTERED AT 337 FEET 72 INCHES
FEET INCHES 425 FEET 48 INCHES
FEET INCHES FEET INCHES

Formation	Color	Hard or Soft	Top	Bottom	Oil, Gas or Water	Depth Found	Remarks
Clay				88			
Slate			88	196			
Sand			196	256			
Slate			256	300			
Sand			300	337			
Coal			337	343			
Slate			343	354			
Sand			354	425			
Coal			425	429			
Slate			429	488			
Sand			488	498			
Slate			498	518			
Sand			518	578			
Slate & Shells			578	680			
Lime			680	892			
Slate			892	932			
Salt Sand			932	1424			
Slate			1424	1435			
Red Rock			1435	1444			
Slate			1444	1450			
Sand			1450	1520			
Black Sand			1520	1564			
Slate			1564	1570			
Little Lime			1570	1595			
Pencil Cave			1595	1602			
Lime			1602	1610			
Pencil Cave			1610	1613			
Big Lime			1613	1782			
Keener Sand			1782	1797			
Slate			1797	1800			
Black Sand			1800	1816			
Red Rock			1816	1822			
Black Sand			1822	1874			
Oil Sand			1874	1896			
Total Depth				1899			

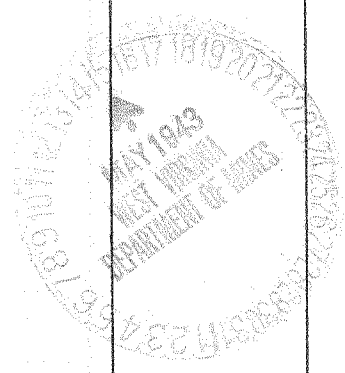

JUL 13 1913

