

Company INTERSTATE PIPE & SUPPLY CO.
 Address MARIETTA, OHIO
 Farm D. J. JARRETT
 Tract _____ Acres 85 1/2 Lease No. _____
 Well (Farm) No 1-2-3-8-14 Serial No. _____
 Elevation (Spirit Level) see above
 Quadrangle CLENDENIN
 County KANAWHA District ELK 7W
 Engineer A. E. PRICE
 Engineer's Registration No. 819
 File No. _____ Drawing No. _____
 Date JUNE 13 1942 Scale 1" = 20.00'

STATE OF WEST VIRGINIA
 DEPARTMENT OF MINES
 OIL AND GAS DIVISION
 CHARLESTON

WELL LOCATION MAP

KAN-402-#8 }
 KAN-415-#14 }
 KAN-392-#1 }
 KAN-401-#2 }
 † Denotes location of well on United States
 Topographic Maps, scale 1 to 62,500, latitude
 and longitude lines being represented
 by border lines as shown.
 — Denotes one inch spaces on border line
 of original tracing.

60-217

D. J. JARRETT HEIRS NO. 1 WELL.

387A

Elk District, Kanawha County, West Virginia.
 The interstate Pipe & Supply Co., Marietta, Ohio.

Abandoned under permit-

On - acres.

Elevation, 602'L.

Drilling completed April 4, 1912.

Casing 6 5/8", 1413'; tubing 2", 1700'.

Coal was encountered at 72'-77'; 237-233'.

Abandonment reported to Dept. of Mines June 10, 1943.

Record to RCT from Mrs. Griffith July 13, 1943. Old File No. 947.

	Top.	Bottom.
Coal	72	- 77
Coal	237	- 243
Sand, Slate, Shells	243	- 727
Salt Sand	727	-1212
Slate & Shells	1212	-1242
Maxon	1242	-1347
Lime	1347	-1387
Clave	1387	-1392
Big Lime	1392	-1545
Big Injun	1545	-1562
Red Rock	1562	-1572
Slate & Shells	1572	-1644
Squaw Sand	1644	-1659
Slate	1659	-1675
Pay	1646	-1659
Total Depth		1689



STATE OF WEST VIRGINIA
DEPARTMENT OF MINES
OIL AND GAS DIVISION

947

WELL RECORD

Permit No. KAN-387-A

Oil or Gas Well Oil
(KIND)

Company The Interstate Pipe & Supply Company
Address Marietta, Ohio
Farm D. J. Jarrett Heirs Acres.....
Location (waters).....
Well No. 1 Elev. 602'
District Elk County Kanawha
The surface of tract is owned in fee by D. J. Jarrett Heirs
Address Pinch, W. Va.
Mineral rights are owned by D. J. Jarrett Heirs
Address Pinch, W. Va.
Drilling commenced.....
Drilling completed April 4, 1912
Date Shot..... From..... To.....
With.....
Open Flow /10ths Water in..... Inch
/10ths Merc. in..... Inch
Volume..... Cu. Ft.
Rock Pressure..... lbs..... hrs.
Oil..... bbls., 1st 24 hrs.
Fresh water..... feet..... feet
Salt water..... feet..... feet


Casing and Tubing	Used in Drilling	Left in Well	Packers
Size			
16			Kind of Packer.....
18			
10			Size of.....
8 1/4			
6 3/8		<u>1413'</u>	Depth set.....
5 3/16			
3			Perf. top.....
2		<u>1700'</u>	Perf. bottom.....
Liners Used.....			Perf. top.....
			Perf. bottom.....

CASING CEMENTED..... SIZE..... No. Ft..... Date.....

COAL WAS ENCOUNTERED AT 72' FEET 60 INCHES
237 FEET 72 FEET INCHES
FEET INCHES FEET INCHES

Formation	Color	Hard or Soft	Top	Bottom	Oil, Gas or Water	Depth Found	Remarks
Coal			72	77			
Coal			237	243			
Sand, Slate, Shells			243	727			
Salt Sand			727	1212			
Slate & Shells			1212	1242			
Maxon			1242	1347			
Lime			1347	1387			
Cave			1387	1392			
Big Lime			1392	1545			
Big Injun			1545	1562			
Red Rock			1562	1572			
Slate & Shells			1572	1644			
Squaw Sand			1644	1659			
Slate			1659	1675			
Pay			1646	1659			
Total Depth				1689			

These formation records have been taken from the South Penn Natural Gas Company Well No. 11 on the Gardner farm, Elevation 810', and allowance has been made for the difference in elevations.

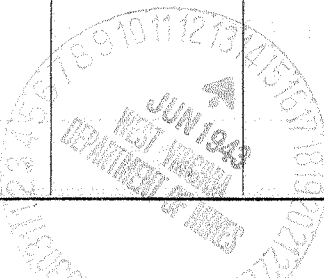

(Over)

JUL 13 1943

