

New Location   
 Drill Deeper   
 Abandonment

APR 19 1944

3.45 W  
 4.6 W

Company UNITED FUEL GAS CO.  
 Address CHARLESTON, W.VA.  
 Farm A.I. GRUBB ET AL  
 Tract \_\_\_\_\_ Acres 60 Lease No. 14056  
 Well (Farm) No. 2 Serial No. 1556  
 Elevation (~~Spot Level~~) 1020 BAROMETER  
 Quadrangle WALTON  
 County KANAWHA District ELK  
 Engineer G.A. Cummings  
 Engineer's Registration No. 659  
 File No. 70-71 Drawing No. \_\_\_\_\_  
 Date APRIL 7, 1944 Scale 1" = 400'

STATE OF WEST VIRGINIA  
 DEPARTMENT OF MINES  
 OIL AND GAS DIVISION  
 CHARLESTON

WELL LOCATION MAP  
 FILE NO. KAN-418-A

+ Denotes location of well on United States Topographic Maps, scale 1 to 62,500, latitude and longitude lines being represented by border lines as shown.  
 - Denotes one inch spaces on border line of original tracing

SW

A.I. GRUBB ET AL. No 2 (1556) - UNITED FUEL GAS CO. - KAN-418-A



STATE OF WEST VIRGINIA  
DEPARTMENT OF MINES  
OIL AND GAS DIVISION

1025

WELL RECORD

Permit No. 418-A Oil or Gas Well GAS  
(KIND)


Company UNITED FUEL GAS COMPANY  
Address Charleston, W. Va.  
Farm A. I. Grubb Acres 60  
Location (waters) Poca Fork of Little Sandy Creek  
Well No. 1556 Elev. 1083  
District Elk County Kanawha  
The surface of tract is owned in fee by A. I. Grubb  
Address Clendenin, W. Va.  
Mineral rights are owned by Same  
Address \_\_\_\_\_  
Drilling commenced Oct. 7, 1925  
Drilling completed Nov. 28, 1925  
Date Shot Not Shot From \_\_\_\_\_ To \_\_\_\_\_

Casing and Tubing	Used in Drilling	Left in Well	Packers
Size			Kind of Packer
16			<u>Anchor</u>
18			Size of <u>3 x 5-3/16</u>
10			Depth set <u>1925</u>
8 1/4	<u>550</u>	<u>Pulled</u>	
6 3/4	<u>1850</u>	<u>1850</u>	
5 3/16			
3			Perf. top
2			Perf. bottom
Liners Used			Perf. top
			Perf. bottom

With \_\_\_\_\_  
Open Flow /10ths Water in \_\_\_\_\_ Inch  
/10ths Merc. in \_\_\_\_\_ Inch  
Volume 290,000 Cu. Ft.  
Rock Pressure 285 lbs. \_\_\_\_\_ hrs.  
Oil \_\_\_\_\_ bbls., 1st 24 hrs.  
Fresh water \_\_\_\_\_ feet  
Salt water 1285 & 1400 feet

CASING CEMENTED \_\_\_\_\_ SIZE \_\_\_\_\_ No. Ft. \_\_\_\_\_ Date \_\_\_\_\_  
COAL WAS ENCOUNTERED AT \_\_\_\_\_ FEET \_\_\_\_\_ INCHES  
\_\_\_\_\_ FEET \_\_\_\_\_ INCHES  
\_\_\_\_\_ FEET \_\_\_\_\_ INCHES

Formation	Color	Hard or Soft	Top	Bottom	Oil, Gas or Water	Depth Found	Remarks
Soil			0	2			
Sand			2	60			
Red Rock			60	100			
Sand			100	135			
Slate			135	250			
Red Rock			250	400			
Sand			400	575			
Slate			575	600			
Sand			600	700			
Lime			700	825			
Sand			825	970			
Slate			970	1000			
Sand			1000	1080			
Slate			1080	1120			
Gas Sand			1120	1220			
Slate			1220	1230			
Salt Sand			1230	1670			
Lime			1670	1695			
Maxon Sand			1695	1775			
Little Lime			1775	1802			
Slate			1802	1804			
Lime Shell			1804	1818			
Pencil Cave			1818	1820			
Big Lime			1820	1961			
Big Injun			1961				
Total Depth			1982				
					Water	1285	
					Water	1400	
					Gas	1315-1330	Hole Full Black
					Oil	1335	
						1914	
					Gas	1963-1974	Hole Reduced

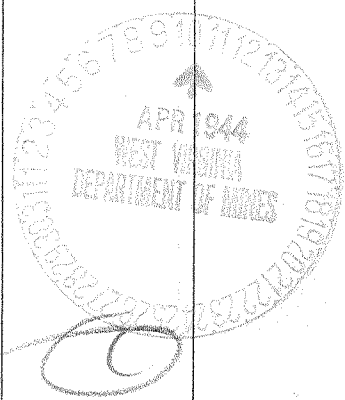

AUG 17 1944

