


0 1 2 3 Latitude 38 35'

1

2

3

Longitude 81 25'

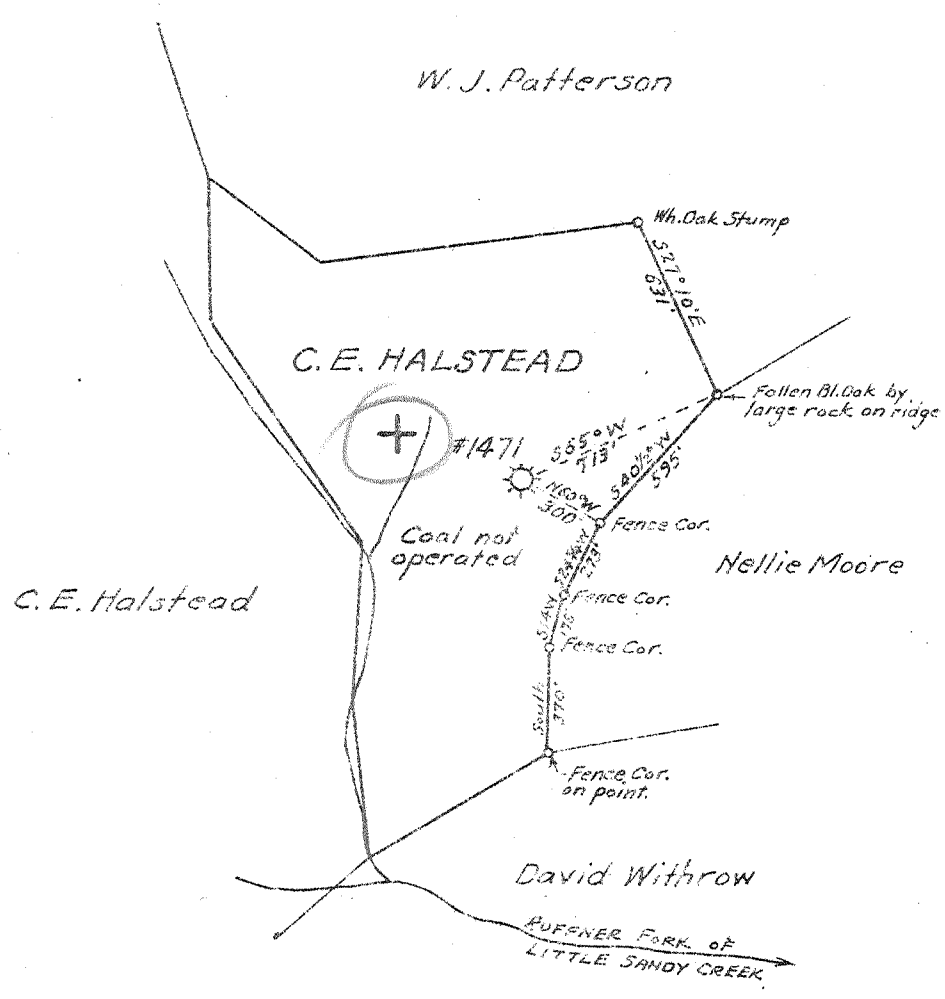

New Location
 Drill Deeper
 Abandonment X

APR 13 1944

Y. 22 W
5, 11

Company	UNITED FUEL GAS CO.
Address	CHARLESTON, W. VA.
Farm	C. E. HALSTEAD
Tract	Acres 40 Lease No. 12172
Well (Farm) No.	1 Serial No. 1471
Elevation	(Spirit Level) 925 BAROMETER
Quadrangle	WALTON
County	KANAWHA District ELK
Engineer	<i>G. A. Cunningham</i>
Engineer's Registration No.	659
File No.	68-69 Drawing No.
Date	APRIL 7, 1944 Scale 1"=660'

STATE OF WEST VIRGINIA
 DEPARTMENT OF MINES
 OIL AND GAS DIVISION
 CHARLESTON

WELL LOCATION MAP
 FILE NO. KAN-419-A

+ Denotes location of well on United States Topographic Maps, scale 1 to 62,500, latitude and longitude lines being represented by border lines as shown.

- Denotes one inch spaces on border line of original tracing.

C. E. HALSTEAD No. 1 (1471) - UNITED FUEL GAS CO. - KAN-419-A