


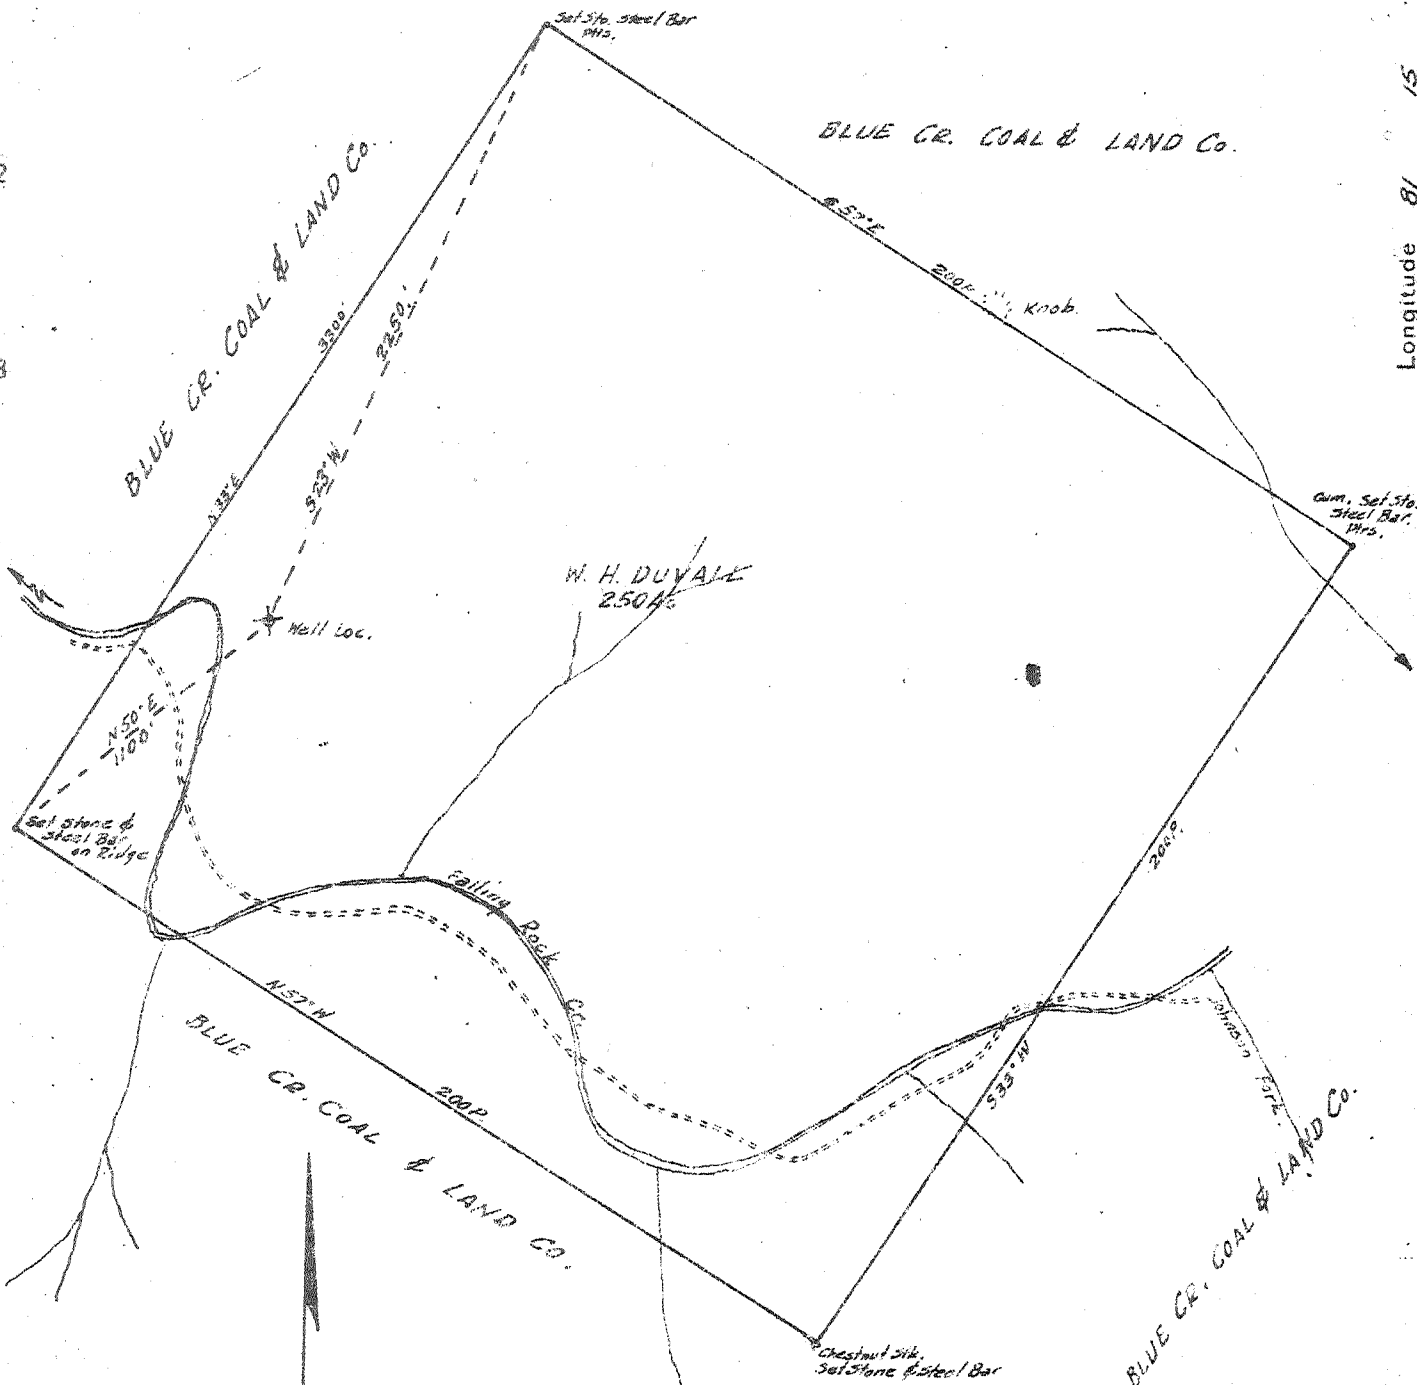

Latitude 25

Longitude 81 15



New Location

Drill Deeper

Abandonment

MAY - 2 1945

4.6 W  
4.53 W  
0.47 W

Company ZOGG & ZOGG, INC.

Address 303 UNION BLDG. - CHARLESTON - W. VA.

Farm W. H. DUYALL

Tract \_\_\_\_\_ Acres 250Ac. Lease No. \_\_\_\_\_

Weil (Farm) No. ONE Serial No. \_\_\_\_\_

Elevation (Spirit Level) 800

Quadrangle CLENDENIN - NE

County KANAWHA District BIG SANDY

Engineer A. E. PRICE

Engineer's Registration No. 819

File No. \_\_\_\_\_ Drawing No. \_\_\_\_\_

Date April 14, 1945 Scale 1" = 660'

STATE OF WEST VIRGINIA  
DEPARTMENT OF MINES  
OIL AND GAS DIVISION  
CHARLESTON

WELL LOCATION MAP  
FILE NO. KAN-428-A

+ Denotes point on United States Topographic Maps, scale 1" = 62,500. Latitude and longitude lines being represented by border lines as shown.

- Denotes one inch spaces on border line of original tracing.

W. H. DUYALL No. 1 -

ZOGG & ZOGG, INC. -

KAN-428-A



COPY

1071

STATE OF WEST VIRGINIA  
DEPARTMENT OF MINES  
OIL AND GAS DIVISION

WELL RECORD

Permit No. KAN-428

Oil or Gas Well \_\_\_\_\_  
(KIND)

Company Zogg and Zogg, Inc.  
Address Charleston, West Virginia  
Farm William Duvall Acres 250  
Location (waters) Falling Rock  
Well No. 1 Elev. 800  
District Big Sandy County Kanawha  
The surface of tract is owned in fee by \_\_\_\_\_  
Address \_\_\_\_\_  
Mineral rights are owned by William Duvall  
Address Blue Creek, W. Va.  
Drilling commenced 1920  
Drilling completed 1920  
Date Shot \_\_\_\_\_ From \_\_\_\_\_ To \_\_\_\_\_  
With \_\_\_\_\_  
Open Flow \_\_\_\_\_ /10ths Water in \_\_\_\_\_ Inch  
\_\_\_\_\_ /10ths Merc. in \_\_\_\_\_ Inch  
Volume 70,000 Cu. Ft.  
Rock Pressure \_\_\_\_\_ lbs. \_\_\_\_\_ hrs.  
Oil \_\_\_\_\_ bbls., 1st 24 hrs.  
Fresh water \_\_\_\_\_ feet \_\_\_\_\_ feet  
Salt water \_\_\_\_\_ feet \_\_\_\_\_ feet

Casing and Tubing	Used in Drilling	Left in Well	Packers
Size			
16			Kind of Packer _____
13			
10			Size of _____
8 1/4			
6 5/8			Depth set _____
5 3/16 Est.	1550	1550	
3			Perf. top _____
2			Perf. bottom _____
Liners Used			Perf. top _____
			Perf. bottom _____

CASING CEMENTED \_\_\_\_\_ SIZE \_\_\_\_\_ No. Ft. \_\_\_\_\_ Date \_\_\_\_\_

COAL WAS ENCOUNTERED AT \_\_\_\_\_ FEET \_\_\_\_\_ INCHES  
\_\_\_\_\_ FEET \_\_\_\_\_ INCHES FEET \_\_\_\_\_ INCHES  
\_\_\_\_\_ FEET \_\_\_\_\_ INCHES FEET \_\_\_\_\_ INCHES

Formation	Color	Hard or Soft	Top	Bottom	Oil, Gas or Water	Depth Found	Remarks
Weir			1868	1885	Gas	1861-1885	
Total Depth				2010			

(Over)

JUN 27 1945



(Title)

By

APPROVED

Owner

Date

194

Formation	Color	Hard or Soft	Top	Bottom	Oil, Gas or Water	Depth Found	Remarks
C. M. ...	Red ...	Cust ...					Report at 1851 ...