

New Location
 Drill Deeper
 Abandonment

AUG - 6 1945

1.9 W
 2.11 X

Company The Pure Oil Company
 Address Newark, Ohio
 Farm Williams Coal Co.
 Tract Acres 12000 Lease No. 5012
 Well (Farm) No. 105 Serial No. 1012
 Elevation (Spirit Level) 1012
 Township Montgomery
 County Kanawha District Cabin Creek
 Engineer J. Hunter
 Engineer's Registration No. Ohio 2912
 File No. _____ Drawing No. _____
 Date Aug 6, 1945 Scale 1" = 200'

STATE OF WEST VIRGINIA
 DEPARTMENT OF MINES
 OIL AND GAS DIVISION
 CHARLESTON

WELL LOCATION MAP
 FILE NO. KAN-432-A

✦ Denotes location of well on United States Topographic Maps, scale 1 to 62,500, latitude and longitude lines being represented by border lines as shown.
 — Denotes one inch spaces on border line of original tracing.



1096

STATE OF WEST VIRGINIA
DEPARTMENT OF MINES
OIL AND GAS DIVISION

WELL RECORD

Permit No. 4307A Oil or Gas Well Oil (KIND)

Company The Pure Oil Company
Address Box 551, Newark, Ohio
Farm Williams Coal Co. Acres 12,000
Location (waters) Cabin Creek
Well No. 105 Elev. 1012'
District Cabin Creek County Kanawha
The surface of tract is owned in fee by Shonk Land Co.
Att. D. C. Shonk Address Dawas, West Va.
Mineral rights are owned by Shonk Land Co.
Att. D. C. Shonk Address Dawas, West Va.
Drilling commenced July 8, 1917
Drilling completed October 12, 1917
Date Shot 12/4/17 From 2722 To 2730
With 40 quarts glycerin

Casing and Tubing	Used in Drilling	Left in Well	Packers
Size			Kind of Packer
16			
13			
10	560	560	Size of
8 1/4	Pulled		
6 5/8	2040	2040	Depth set
5 3/16			
3			Perf. top
2			Perf. bottom
Liners Used			Perf. top
			Perf. bottom

Open Flow /10ths Water in _____ Inch
/10ths Merc. in _____ Inch
Volume _____ Cu. Ft.
Rock Pressure _____ lbs. _____ hrs.
Oil 14 bbls., 1st 24 hrs.
Fresh water _____ feet
Salt water _____ feet


CASING CEMENTED _____ SIZE _____ No. Ft. _____ Date _____

COAL WAS ENCOUNTERED AT 25 FEET 48 INCHES
109 FEET 36 INCHES 256 FEET 36 INCHES
330 FEET 36 INCHES 420 FEET 60 INCHES
606 48

Formation	Color	Hard or Soft	Top	Bottom	Oil, Gas or Water	Depth Found	Remarks
oil			0	14			
and			14	20			
late			20	25			
coal			25	29			
and			29	109			
coal			109	112			
late			112	256			
coal			256	259			
and			259	330			
coal			330	333			
and			333	415			
late			415	420			
coal			420	425			
and			425	520			
late			520	606			
coal			606	610			
lime & Shells			610	635			
late			635	735			
and			735	900			
RAMFUS			900	1000			
LIE SAND			1000	1400			
late			1400	1405	Water	1300	Half Full
lime			1405	1475			
late			1475	1485			
lime			1485	1530			
late			1530	1560			
rd Rock			1560	1590			
lime & Shells			1590	1610			
rd Rock			1610	1795			
late			1795	1860			
LKON SAND			1860	1955			
late			1955	1960			
ttle lime			1960	1990			
late			1990	2005			
lime & Shells			2005	2010			
late			2010	2040			
CG LIME			2040	2280			
late			2280	2290			

(Over)

NOV - 6 1945

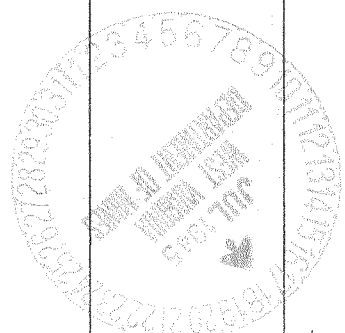

Formation	Color	Hard or Soft	Top	Bottom	Oil, Gas or Water	Depth Found	Remarks
UNION SAND			2290	2330			
late & Shells			2330	2699			
AREA GRIT			2699	2730	Gas, 1st oil	2722'	
late & Lime			2730	2734			
TOTAL DEPTH: 2734'							

Date July 16, 194 5
 APPROVED Ford Wells THE PURE OIL COMPANY, P.O. Box 551
 Division Superintendent Newark, Ohio, Owner
 By _____ (Title)