

ABANDONMENT X

COMPANY THE PURE OIL COMPANY

ADDRESS NEWARK, OHIO

FARM WILLIAMS COAL COMPANY

TRACT ACRES 12,000 LEASE NO. 5012

WELL (FARM) NO. 11 SERIAL NO. 215

ELEVATION (S.L.) 1144

QUADRANGLE MONTGOMERY

COUNTY KANAWHA DISTRICT CABIN CREEK

ENGINEER J. B. HUNTER

ENGINEER'S REG. NO. OHIO - 2912

FILE NO. _____ DRAWING NO. _____

DATE 7/2/46 SCALE 1" - 200'

STATE OF WEST VIRGINIA
DEPARTMENT OF MINES
OIL AND GAS DIVISION
CHARLESTON
WELL LOCATION MAP
FILE NO. KAN 450-A

+ DENOTES LOCATION OF WELL ON U.S. TOPOGRAPHIC MAPS, SCALE 1 TO 62,500, LATITUDE AND LONGITUDE LINES BEING PRESENTED BY BORDER LINES AS SHOWN.

- DENOTES ONE INCH SPACES ON BORDER LINE OF ORIGINAL TRACING.

6-6-40

WILLIAMS COAL CO. 11 (215) - PURE OIL CO. - KAN 450-A



STATE OF WEST VIRGINIA
DEPARTMENT OF MINES
OIL AND GAS DIVISION

1193

WELL RECORD

Permit No. 450-A Oil or Gas Well Oil
(KIND)


Company The Pure Oil Company
Address Box 551 - Newark, Ohio
Farm Williams Coal Company Acres 12,000
Location (waters) Loughnutten Creek
Well No. 11 Elev. 1144'
District Cabin Creek County Kanawha
The surface of tract is owned in fee by Shonk Land Company
Att. D. G. Shonk Address Dawson, W. Va.
Mineral rights are owned by Shonk Land Company
Att. D. G. Shonk Address Dawson, W. Va.
Drilling commenced September 23, 1915
Drilling completed November 19, 1915
Date Shot 11/23/15 From 2801' To 2818'
With 50 quarts glycerin
Open Flow /10ths Water in _____ Inch
/10ths Merc. in _____ Inch
Volume _____ Cu. Ft.
Rock Pressure _____ lbs _____ hrs.
Oil 180 bbls., 1st 24 hrs.
Fresh water _____ feet
Salt water _____ feet

Casing and Tubing	Used in Drilling	Left in Well	Packers
Size			
16			Kind of Packer
13			
10	655'	655'	Size of
8 1/4	1492	Pulled	
6 3/8	2141'	2141'	Depth set
5 3/16	2163'	2163'	
3			Perf. top
2			Perf. bottom
Liners Used			Perf. top
			Perf. bottom

CASING CEMENTED _____ SIZE _____ No. Ft. _____ Date _____

COAL WAS ENCOUNTERED AT 75 FEET 60 INCHES
260 FEET 56 INCHES 575 FEET 24 INCHES
599 FEET 24 INCHES 701 FEET 50 INCHES

Formation	Color	Hard or Soft	Top	Bottom	Oil, Gas or Water	Depth Found	Remarks
Clay	yellow		0	9			
Sand	brown		9	50			
Slate	black		50	75			
Coal	black		75	80			
Sand	white		80	150	cement		
Slate	black		150	175			
Lime	black		175	200			
Sand	gray		200	240			
Slate	white		240	260			
Coal	black		260	265	cement		
Lime	black		265	280			
Sand	white		280	320			
Slate	black		320	334			
Lime	black		334	350			
Sand	white		350	380			
Slate	black		380	400			
Sand	gray		400	420			
Slate	white		420	434			
Lime	white		434	460			
Sand	white		460	500			
Slate	black		500	520			
Sand	white		520	565			
Slate	black		565	575			
Coal	black		575	577	can		
Lime	white		577	585	clay		
Slate	black		585	599	cement		
Coal	black		599	601			
Lime	white		601	620			
Sand	gray		620	640			
Slate	white		640	650			
Sand	white		650	680			
Slate	black		680	701			
Coal	black		701	704	can		
Slate	black		704	735	clay		
Sand	white		735	806			
Slate	white		806	865			
Sand	white		865	920			
Slate	black		920	945			

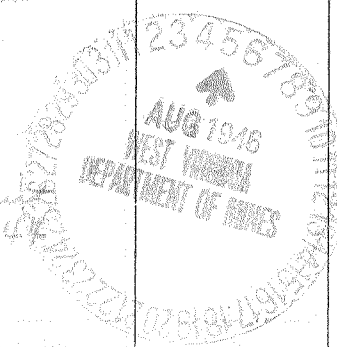

Formation	Color	Hard or Soft	Top	Bottom	Oil, Gas or Water	Depth Found	Remarks
Sand	gray		945	1015			
Lime	yellow		1015	1105	P-1145		
Slate	black		1105	1165			
SALT SAND	white		1165	1490			
Lime & Slate	white		1490	1630	By 1530		
Rock	red		1630	1825			
Slate	white		1825	2045			
Pencil Slate	black		2045	2050			
Little Lime	black		2050	2135	P-2115		
Pencil Slate	black		2135	2155			
SIX LIMB	white		2155	2365	P-2345		
ENGL SAND	red		2365	2410	P-2410		
Slate & Shell	white		2410	2775	P-2765		
Shale	brown		2775	2785			
BEREA SAND	white		2785	2815			
Lime	black		2815	2825			
	TOTAL DEPTH:			2825			

Date August 3, 1946

The Pure Oil Company
Box 551, Newark, Ohio

APPROVED

Owner

By Frank Miller
Division Superintendent