

New Location   
 Drill Deeper   
 Abandonment

Company VIRGINIAN GASOLINE & OIL CO.  
 Address CHARLESTON, W. VA.  
 Farm C.C. & W.E. MYERS  
 Tract \_\_\_\_\_ Acres 8 Lease No. 777  
 Well (Farm) No. 1 Serial No. 2819  
 Elevation (Spirit Level) 712  
 Quadrangle CLENDENIN  
 County KANAWHA District ELK  
 Engineer \_\_\_\_\_  
 Engineer's Registration No. 662  
 File No. 70-65 Drawing No. \_\_\_\_\_  
 Date OCT. 8, 1947 Scale 1" = 400'

STATE OF WEST VIRGINIA  
 DEPARTMENT OF MINES  
 OIL AND GAS DIVISION  
 CHARLESTON

WELL LOCATION MAP  
 FILE NO. KAN-486-A

+ Denotes location of well on United States Topographic Maps, scale 1 to 62,500, latitude and longitude lines being represented by border lines as shown.  
 - Denotes one inch spaces on border line of original tracing.

C.C. & W.E. MYERS No. 1 (2819) - VIRGINIAN GASOLINE & OIL CO. - KAN-486-A



STATE OF WEST VIRGINIA  
DEPARTMENT OF MINES  
OIL AND GAS DIVISION

1267

WELL RECORD

Oil or Gas Well **Oil**  
(KIND)

Permit No. 486-A

Abandonment


Company VIRGINIAN GASOLINE & OIL COMPANY  
Address P.O. Box 1273, Charleston 25, W. Va.  
Farm C. C. & W. E. Myers Acres 8  
Location (waters) Inhoff Br.  
Well No. 2819 Elev. 712 Level  
District Elk County Kanawha  
The surface of tract is owned in fee by \_\_\_\_\_  
Address \_\_\_\_\_  
Mineral rights are owned by C. C. & W. E. Myers  
Route 4 Address Bidwell, Ohio  
Drilling commenced 12-16-1911  
Drilling completed 1-29-1912  
Date Shot No. Record From \_\_\_\_\_ To \_\_\_\_\_  
With \_\_\_\_\_

Casing and Tubing	Used in Drilling	Left in Well	Packers
Size			Kind of Packer
16			
13			
10	44"	44"	Size of <u>Bo 7 1/2"</u>
8 1/4	490"	490"	
6 1/2	1527"	1527"	Depth set <u>17' left</u>
5 3/16			
3			Perf. top
2			Perf. bottom
Liners Used			Perf. top
			Perf. bottom

Open Flow \_\_\_\_\_ /10ths Water in \_\_\_\_\_ Inch  
\_\_\_\_\_ /10ths Merc. in \_\_\_\_\_ Inch  
Volume \_\_\_\_\_ Cu. Ft.  
Rock Pressure \_\_\_\_\_ lbs. \_\_\_\_\_ hrs.  
Oil \_\_\_\_\_ bbls., 1st 24 hrs.  
Fresh water 90' feet \_\_\_\_\_ feet  
Salt water 930' feet \_\_\_\_\_ feet

CASING CEMENTED \_\_\_\_\_ SIZE \_\_\_\_\_ No. Ft. \_\_\_\_\_ Date \_\_\_\_\_  
COAL WAS ENCOUNTERED AT \_\_\_\_\_ FEET \_\_\_\_\_ INCHES  
\_\_\_\_\_ FEET \_\_\_\_\_ INCHES \_\_\_\_\_ FEET \_\_\_\_\_ INCHES  
\_\_\_\_\_ FEET \_\_\_\_\_ INCHES \_\_\_\_\_ FEET \_\_\_\_\_ INCHES

Formation	Color	Hard or Soft	Top	Bottom	Oil, Gas or Water	Depth Found	Remarks
Slate			480	490	Water	90'	
Shells & Slate			490	575			
Sand			575	640			
Slate			640	670			
Sand			670	715			
Slate			715	735			
Sand			735	770			
Slate & Shells			770	800			
Salt Sand			800	1290	Oil	800	Show
Red Rock			1290	1300	Water	930	Big Water
Maxon Sand			1300	1348			
Red Rock			1348	1376			
White Slate			1376	1400			
Shells			1400	1415			
Red Rock			1415	1430			
Sand			1430	1445			
Slate			1445	1464			
Little Lime			1464	1490			
Pencil Cave			1490	1496			
Sand & Slate			1496	1516			
Big Lime			1516	1677			
Red Rock			1677	1686			
Slate & Sand			1686	1750			
Oil Sand			1750	1774			
Total Depth:				1774'			

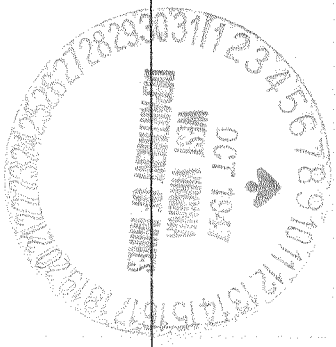

(Over)

NOV 25 1917

