

New Location...   
 Drill Deeper.....   
 Abandonment.....

APR. 15 1957

NOW: W. L. HEATER - SPENCER, W. VA.

Company VIRGINIAN GASOLINE & OIL CO.  
 Address CHARLESTON, W. VA.  
 Farm C.C. & W.E. MYERS  
 Tract \_\_\_\_\_ Acres 8 Lease No. 777  
 Well (Farm) No. 2 Serial No. 3852  
 Elevation (Spirit Level) 745'  
 Quadrangle CLENDENIN  
 County KANAWHA District ELK  
 Engineer [Signature]  
 Engineer's Registration No. 662  
 File No. 70-65 Drawing No. \_\_\_\_\_  
 Date OCT-23-1947 Scale 1"=400'

STATE OF WEST VIRGINIA  
 DEPARTMENT OF MINES  
 OIL AND GAS DIVISION  
 CHARLESTON

WELL LOCATION MAP  
 FILE NO. KAN-488-A - # 3852

+ Denotes location of well on United States Topographic Maps, scale 1 to 62,500, latitude and longitude lines being represented by border lines as shown.

- Denotes one inch spaces on border line of original tracing.

(Now W. L. HEATER)

C.C. & W.E. MYERS No. 2 (3852) - VIRGINIAN GASOLINE & OIL CO. - KAN-488-A

*Decided not to  
abandon*



STATE OF WEST VIRGINIA  
DEPARTMENT OF MINES  
OIL AND GAS DIVISION

1268

WELL RECORD  
ABANDONMENT

Oil or Gas Well Oil  
(KIND)

Permit No. 188-A


Company VIRGINIAN GASOLINE & OIL COMPANY  
Address P.O. Box 1273, Charleston 25, W. Va.  
Farm C. C. & W. E. Myers Acres 8  
Location (waters) Imhoff Br.  
Well No. 3852 Elev. 745  
District Elk County Kanawha  
The surface of tract is owned in fee by \_\_\_\_\_  
Address \_\_\_\_\_  
Mineral rights are owned by C. C. & W. E. Myers  
Route #4 Address Bidwell, Ohio  
Drilling commenced 3-7-1912  
Drilling completed \_\_\_\_\_  
Date Shot 4-15-12 From 1772 To 1792  
With 80 qts.  
Open Flow /10ths Water in \_\_\_\_\_ Inch  
/10ths Merc. in \_\_\_\_\_ Inch  
Volume \_\_\_\_\_ Cu. Ft.  
Rock Pressure \_\_\_\_\_ lbs. \_\_\_\_\_ hrs.  
Oil \_\_\_\_\_ bbls., 1st 24 hrs.  
Fresh water \_\_\_\_\_ feet \_\_\_\_\_ feet  
Salt water \_\_\_\_\_ feet \_\_\_\_\_ feet

Casing and Tubing	Used in Drilling	Left in Well	Packers
Size			Kind of Packer
16			
18			
10	73' 8"	73' 8"	Size of
8 1/4	494'	Pulled	
6 5/8	1555' 10"	1555' 10"	Depth set
5 3/16	1627	1627	
3			Perf. top
2			Perf. bottom
Liners Used			Perf. top
			Perf. bottom

CASING CEMENTED \_\_\_\_\_ SIZE \_\_\_\_\_ No. Ft. \_\_\_\_\_ Date \_\_\_\_\_

COAL WAS ENCOUNTERED AT \_\_\_\_\_ FEET \_\_\_\_\_ INCHES  
\_\_\_\_\_ FEET \_\_\_\_\_ INCHES \_\_\_\_\_ FEET \_\_\_\_\_ INCHES  
\_\_\_\_\_ FEET \_\_\_\_\_ INCHES \_\_\_\_\_ FEET \_\_\_\_\_ INCHES

Formation	Color	Hard or Soft	Top	Bottom	Oil, Gas or Water	Depth Found	Remarks
Squaw			1772	1790			
Total Depth:				1794'			
<u>This is the only record we have on this Well</u>							

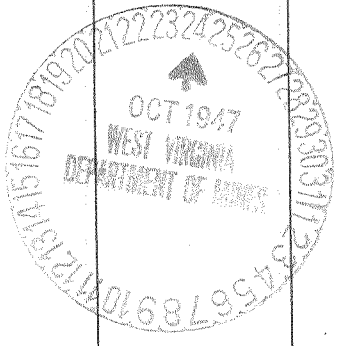

NOV 23 1947





1588-12  
2018

STATE OF WEST VIRGINIA  
DEPARTMENT OF MINES  
OIL AND GAS DIVISION

COPY

Quadrangle \_\_\_\_\_

Permit No. 488-A

WELL RECORD

Oil or Gas Well Oil  
(KIND)

Company Virginian Gasoline & Oil Company  
Address Charleston, W. Va.  
Farm C. C. & W. E. Myers Acres 8  
Location (waters) Imhoff Branch  
Well No. 3852 Elev. 745'  
District Elk County Kanawha  
The surface of tract is owned in fee by C. C. & W. E. Myers  
RFD #4 Address Bidwell, Ohio  
Mineral rights are owned by \_\_\_\_\_  
Address \_\_\_\_\_

Casing and Tubing	Used in Drilling	Left in Well	Packers
Size			
16			Kind of Packer
13			
10	73"8"	73"8"	Size of
8 1/4	49 1/2"	Pulled	
6 5/8	1555'10"	1555'10"	Depth set
5 3/16	1627'	1627'	
3			Perf. top
2			Perf. bottom
Liners Used			Perf. top
			Perf. bottom

Drilling commenced \_\_\_\_\_  
Drilling completed 3/7-1912  
Date Shot 4/15-1912 From 1772' To 1792'  
With 80 qts.  
Open Flow \_\_\_\_\_ /10ths Water in \_\_\_\_\_ Inch  
\_\_\_\_\_ /10ths Merc. in \_\_\_\_\_ Inch  
Volume \_\_\_\_\_ Cu. Ft.  
Rock Pressure \_\_\_\_\_ lbs. \_\_\_\_\_ hrs.  
Oil \_\_\_\_\_ bbls., 1st 24 hrs.  
Fresh water \_\_\_\_\_ feet \_\_\_\_\_ feet  
Salt water \_\_\_\_\_ feet \_\_\_\_\_ feet

CASING CEMENTED \_\_\_\_\_ SIZE \_\_\_\_\_ No. Ft. \_\_\_\_\_ Date \_\_\_\_\_  
COAL WAS ENCOUNTERED AT \_\_\_\_\_ FEET \_\_\_\_\_ INCHES  
\_\_\_\_\_ FEET \_\_\_\_\_ INCHES FEET \_\_\_\_\_ INCHES  
\_\_\_\_\_ FEET \_\_\_\_\_ INCHES FEET \_\_\_\_\_ INCHES

Formation	Color	Hard or Soft	Top	Bottom	Oil, Gas or Water	Depth Found	Remarks
Squaw Sand			1772	1790			
Total Depth				1794'			
This is the only record we have on this well							



(Over)

JUN 20 1917