

New Location   
 Drill Deeper   
 Abandonment

Company UNITED FUEL GAS CO.  
 Address CHARLESTON, W.VA.  
 Farm L. W. SEABOLT, ET. AL.  
 Tract \_\_\_\_\_ Acres 48 Lease No. 12114  
 Well (Farm) No. 1 Serial No. 1082  
 Elevation (Spirit Level) 1078.0'  
 Quadrangle WALTON  
 County KANAWHA District BIG SANDY  
 Engineer J. H. Moore  
 Engineer's Registration No. 662  
 File No. 74-69 Drawing No. \_\_\_\_\_  
 Date MARCH 19, 1947 Scale 1" = 400'

STATE OF WEST VIRGINIA  
 DEPARTMENT OF MINES  
 OIL AND GAS DIVISION  
 CHARLESTON

WELL LOCATION MAP  
 FILE NO. KAN-490-A-#1082

⊕ Denotes location of well on United States Topographic Maps, scale 1 to 62,500, latitude and longitude lines being represented by border lines as shown.  
 — Denotes one inch spaces on border line of original tracing.

L. W. SEABOLT NO. 1 (1082) - UNITED FUEL GAS CO. - KAN-490-A



1276

STATE OF WEST VIRGINIA  
DEPARTMENT OF MINES  
OIL AND GAS DIVISION

WELL RECORD

Oil or Gas Well Gas  
(KIND)

ABANDONMENT

Permit No. 490-A

Company UNITED FUEL GAS CO.,

Address P.O. Box 1273, Charleston 25, W. Va.

Farm L. W. Seabolt Acres 48-1/4-A

Location (waters) Doctors Creek

Well No. 1082 Elev. 1078

District Big Sandy County Kanawha

The surface of tract is owned in fee by \_\_\_\_\_  
Address \_\_\_\_\_

Mineral rights are owned by G. W. Grubb, Agt. et al  
Big Chimney Address West Virginia

Drilling commenced 8-25-1919

Drilling completed 11-10-1919

Date Shot 11-11-1919 From 2240 To 2247

With 30 Qts.

Open Flow \_\_\_\_\_ /10ths Water in \_\_\_\_\_ Inch  
\_\_\_\_\_ /10ths Merc. in \_\_\_\_\_ Inch

Volume \_\_\_\_\_ Cu. Ft.

Rock Pressure 180 lbs. Not Given hrs.

Oil \_\_\_\_\_ bbls., 1st 24 hrs.

Fresh water \_\_\_\_\_ feet \_\_\_\_\_ feet


Salt water \_\_\_\_\_ feet \_\_\_\_\_ feet

Casing and Tubing	Used in Drilling	Left in Well	Packers
Size			Kind of Packer
16			<u>Bottom Hole</u>
13			Size of <u>6-5/8"</u>
10	<u>15' - 11"</u>	<u>15' - 11"</u>	Depth set <u>358'</u> <u>from Bottom</u>
8 1/4	<u>500'</u>	<u>410'</u>	Perf. top _____
6 3/4	<u>1910'</u>	<u>1910'</u>	Perf. bottom _____
5 3/16			Perf. top _____
3			Perf. bottom _____
2	<u>19 14 11"</u>		
Liners Used			

CASING CEMENTED \_\_\_\_\_ SIZE \_\_\_\_\_ No. Ft. \_\_\_\_\_ Date \_\_\_\_\_

COAL WAS ENCOUNTERED AT \_\_\_\_\_ FEET \_\_\_\_\_ INCHES  
\_\_\_\_\_ FEET \_\_\_\_\_ INCHES FEET \_\_\_\_\_ INCHES  
\_\_\_\_\_ FEET \_\_\_\_\_ INCHES FEET \_\_\_\_\_ INCHES

Formation	Color	Hard or Soft	Top	Bottom	Oil, Gas or Water	Depth Found	Remarks
Slate & Red Rock				420			
Sand & Slate			420	840			
Slate & Shell			840	1320			
1st Salt Sand			1320	1470			
Slate			1470	1480			
2nd Salt Sand			1480	1660			
Slate			1660	1710			
Maxon			1710	1838			
Little Lime			1838	1868			
Slate			1868	1870			
Lime			1870	1877			
Pencil Cave			1877	1880			
Big Lime			1880	2013			
Big Injun			2013	2043			
Well Weir			2241	2265	<u>Gas</u>	<u>2013-2043</u>	
Total Depth:				2268'	<u>Oil</u>	<u>2242</u>	<u>Show</u>

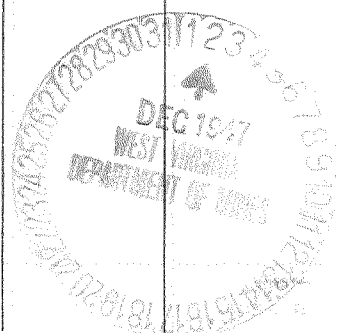

2268  
558  
1910

MAR 20 1948

