

Company VIRGINIAN GASOLINE & OIL CO.
 Address CHARLESTON, W. VA.
 Farm G. W. WHITE
 Tract _____ Acres 80 Lease No. 752
 Well (Farm) No. AS SHOWN Serial No. 2832, 2850, 2873 & 2818
 Elevation (Spirit Level) AS SHOWN
 Quadrangle CLENDENIN
 County KANAWHA District ELK
 Engineer _____
 Engineer's Registration No. 662
 File No. 70-65 Drawing No. _____
 Date APRIL 14, 1948 Scale 1" = 400'

STATE OF WEST VIRGINIA
 DEPARTMENT OF MINES
 OIL AND GAS DIVISION
 CHARLESTON

WELL LOCATION MAP
 FILE NO. KAN-495-A #2832

+ Denotes location of well on United States Topographic Maps, scale 1 to 62,500, latitude and longitude lines being represented by border lines as shown.
 - Denotes one inch spaces on border line of original tracing.

G. W. WHITE No. 2832 (B) VIRGINIAN GAS & OIL CO. - KAN-495-A



STATE OF WEST VIRGINIA
DEPARTMENT OF MINES
OIL AND GAS DIVISION

WELL RECORD

Oil or Gas Well Oil
(KIND)

Completed No inspection made September 4-1948

1257

495-A

Permit No. _____
ABANDONMENT


Company VIRGINIAN GASOLINE & OIL COMPANY
Address P.O. Box 1273, Charleston 25, W. Va.
Farm Geo. W. White Acres 80
Location (waters) Buffalo Lick Br.
Well No. 2832 Elev. 666 Level
District Elk County Kanawha
The surface of tract is owned in fee by _____
Address _____
Mineral rights are owned by J. I. White, Agent, et al
120 1/2 Washington St. Address Charleston, W. Va.
Drilling commenced 3-8-12
Drilling completed 6-30-12
Date Shot Not Given From 1725' To 1740'
With _____
Open Flow _____ /10ths Water in _____ Inch
_____ /10ths Merc. in _____ Inch
Volume _____ Cu. Ft.
Rock Pressure _____ lbs. _____ hrs.
Oil 400 bbls., 1st 24 hrs.
Fresh water _____ feet _____ feet
Salt water 820 feet _____ feet

Casing and Tubing	Used in Drilling	Left in Well	Packers
Size			Kind of Packer
16			
13			
10	<u>38'</u>	<u>38'</u>	Size of
8 1/4	<u>379'</u>	<u>Pulled</u>	
6 1/2	<u>1490'</u>	<u>1490'</u>	Depth set
5 3/16			
3			Perf. top
2			Perf. bottom
Liners Used			Perf. top
			Perf. bottom

CASING CEMENTED _____ SIZE _____ No. Ft. _____ Date _____

COAL WAS ENCOUNTERED AT _____ FEET _____ INCHES
_____ FEET _____ INCHES _____ FEET _____ INCHES
_____ FEET _____ INCHES _____ FEET _____ INCHES

Formation	Color	Hard or Soft	Top	Bottom	Oil, Gas or Water	Depth Found	Remarks
Slate			40	250			
Shale			250	320			
Sand			320	370			
Slate & Shale			370	720			
Salt Sand			720	1250			
Slate			1250	1300			
Red Rock			1300	1350			
Slate			1350	1445			
Little Line			1445	1460			
Cave			1460	1475			
Big Line			1475	1650			
Red Rock			1650	1675			
Line Shells & Slate			1675	1707			
Top of Shell			1707	1722			
Squaw Sand			1722	1740			
Bottom of Hole			1740'				
							Hole full of water at 820' First Oil at 1723' Flowing steady at 1725' Stopped Drilling at 1740' No Coal seen recorded. Coal elevation figured from logs of surrounding wells.

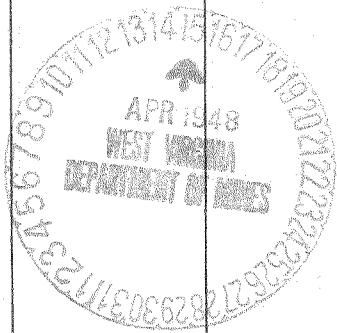

(Over)

JUN 18 1948

Formation	Color	Hard or Soft	Top	Bottom	Oil, Gas or Water	Depth Found	Remarks

Date April 14, _____, 19 48

APPROVED VIRGINIAN GASOLINE & OIL COMPANY, Owner

By G. H. Moore _____
Chief Engineer (Title) R.

