

Company VIRGINIAN GASOLINE & OIL CO.  
 Address CHARLESTON, W. VA.  
 Farm G. W. WHITE  
 Tract \_\_\_\_\_ Acres 80 Lease No. 752  
 Well (Farm) No. AS SHOWN Serial No. 2931, 2886, 2873, 2850, 2832, 2818  
 Elevation (Spirit Level) AS SHOWN  
 Quadrangle CLENDENIN  
 County KANAWHA District ELK NW  
 Engineer J. W. Moore  
 Engineer's Registration No. 662  
 File No. 70-65 Drawing No. \_\_\_\_\_  
 Date APRIL 14, 1948 Scale 1" = 400'

STATE OF WEST VIRGINIA  
 DEPARTMENT OF MINES  
 OIL AND GAS DIVISION  
 CHARLESTON

**WELL LOCATION MAP**

FILE NO. KAN-495-A #2832  
KAN-501-A KAN-499-A #2850  
#2931 KAN-500-A #2873

+ Denotes location of well on United States Topographic Maps, scale 1 to 62,500, latitude and longitude lines being represented by border lines as shown.

- Denotes one inch spaces on border line of original tracing.





STATE OF WEST VIRGINIA  
DEPARTMENT OF MINES  
OIL AND GAS DIVISION

*This well completed  
Have not been able to  
Get complet tally on  
pipe*

**316**

AP  
499-A

WELL RECORD  
ABANDONMENT

Oil or Gas Well Oil  
(KIND)

Permit No. \_\_\_\_\_  
Company Virginian Gasoline & Oil Company  
Address P.O. Box 1273, Charleston 25, W.Va.  
Farm George W. White Acres 80  
Location (waters) Buffalo Lick Br.  
Well No. 2850 Elev. 788 L  
District Elk County Kanawha  
The surface of tract is owned in fee by \_\_\_\_\_  
Address \_\_\_\_\_  
Mineral rights are owned by J.I. White, Agent, etal  
120 1/2 Washington St. Address Charleston, W.Va.  
Drilling commenced 3-5-12  
Drilling completed 4-20-12  
Date Shot Not shown From \_\_\_\_\_ To \_\_\_\_\_  
With \_\_\_\_\_  
Open Flow \_\_\_\_\_ /10ths Water in \_\_\_\_\_ Inch  
\_\_\_\_\_ /10ths Merc. in \_\_\_\_\_ Inch  
Volume \_\_\_\_\_ Cu. Ft.  
Rock Pressure \_\_\_\_\_ lbs. \_\_\_\_\_ hrs.  
Oil 1000 (Squaw) bbls., 1st 24 hrs.  
Fresh water \_\_\_\_\_ feet \_\_\_\_\_ feet  
Salt water \_\_\_\_\_ feet \_\_\_\_\_ feet

Casing and Tubing	Used in Drilling	Left in Well	Packers
Size			
16			Kind of Packer
13			
10	58'	58'	Size of <i>rel</i>
<del>8 1/2</del> 8"	505'	Pulled	
6 5/8" 1500	1622'	1622'	Depth set
5 3/16" 9" 4 3/4"	<i>Run after</i>	<i>was pulled</i>	
3" <i>Dropped 100 feet</i>	<i>1 Joint</i>		Perf. top <i>act</i>
2			Perf. bottom
Liners Used			Perf. top
			Perf. bottom


CASING CEMENTED \_\_\_\_\_ SIZE \_\_\_\_\_ No. Ft. \_\_\_\_\_ Date \_\_\_\_\_  
COAL WAS ENCOUNTERED AT 480 FEET 48 INCHES  
\_\_\_\_\_ FEET \_\_\_\_\_ INCHES FEET \_\_\_\_\_ INCHES  
\_\_\_\_\_ FEET \_\_\_\_\_ INCHES FEET \_\_\_\_\_ INCHES

Formation	Color	Hard or Soft	Top	Bottom	Oil, Gas or Water	Depth Found	Remarks
Sand			58'	150'			
Red Rock			150	180			
Slate			180	480			
Coal			480	484			
Sand			484	505			
Slate			505	900			
Salt Sand			900	1380			
Hard Cave			1380	1400			
Black Sand			1400	1500			
Lime			1500	1540			
Shale			1540	1560			
Little Lime			1560	1582			
Pencil Cave			1582	1584			
Sand			1584	1620			
Big Lime			1620	1775			
Red Rock			1775	1800			
Slate & Shell			1800	1835			
Shell			1835	1841			
Sand & Oil			1841	1854			
Total Depth				1854'			





Formation	Color	Hard or Soft	Top	Bottom	Oil, Gas or Water	Depth Found	Remarks
			1877	1877			
			1872	1877			
			1800	1872			
			1772	1800			
			1750	1772			
			1727	1750			
			1725	1727			
			1720	1725			
			1700	1720			
			1780	1700			
			800	1780			
			202	800			
			187	202			
			180	187			
			180	180			
			170	180			
			170	170			

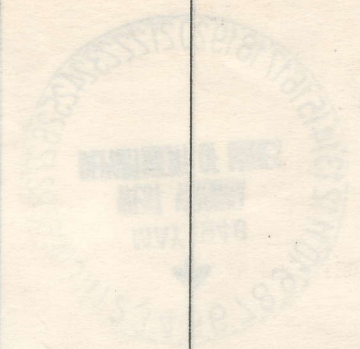

Formation	Color	Hard or Soft	Top	Bottom	Oil, Gas or Water	Depth Found	Remarks
Soft shale		Soft	1000				
Block shale		Hard					
Oil							
Rock							
Shale							
Open rock							
Wet							
Dark gray							
Drilling							
Drilling							
120'							
100'							
70'							
50'							
30'							
10'							
5'							
2'							
1'							
0'							

DEPARTMENT OF MINES  
STATE OF WEST VIRGINIA

Date April 30, 19 48

APPROVED Virginian Gasoline & Oil Co., Owner

By J. H. Moore  
Chief Engineer. (Title) R

