

New Location   
 Drill Deeper   
 Abandonment

Company VIRGINIAN GASOLINE & OIL CO.  
 Address CHARLESTON, W. VA.  
 Farm S. SPENCER MOORE  
 Tract \_\_\_\_\_ Acres 100 Lease No. 779  
 Well (Farm) No. 3 Serial No. 2891  
 Elevation (Spirit Level) 810.8'  
 Quadrangle CLENDENIN  
 County KANAWHA District ELK  
 Engineer [Signature]  
 Engineer's Registration No. 662  
 File No. 70-63 Drawing No. \_\_\_\_\_  
 Date APRIL 14, 1948 Scale 1" = 400'

STATE OF WEST VIRGINIA  
 DEPARTMENT OF MINES  
 OIL AND GAS DIVISION  
 CHARLESTON

**WELL LOCATION MAP**  
 FILE NO. KAN-504-A

+ Denotes location of well on United States Topographic Maps, scale 1 to 62,500. latitude and longitude lines being represented by border lines as shown.  
 - Denotes one inch spaces on border line of original tracing.



STATE OF WEST VIRGINIA  
DEPARTMENT OF MINES  
OIL AND GAS DIVISION

1303A

WELL RECORD

Permit No. 54-A ABANDONMENT Oil or Gas Well 011  
(KIND)


Company VIRGINIAN GASOLINE & OIL COMPANY  
Address P.O. Box 1273, Charleston 25, W. Va.  
Farm S. S. Moore Acres 100  
Location (waters) Elk River  
Well No. 2891 Elev. 810.8 (Level)  
District Elk County Kenawha  
The surface of tract is owned in fee by \_\_\_\_\_  
Address \_\_\_\_\_  
Mineral rights are owned by Central Trust Co.  
Attorney in Fact Address Charleston, W. Va.  
Drilling commenced 5-17-12  
Drilling completed 6-25-12  
Date Shot \_\_\_\_\_ From \_\_\_\_\_ To \_\_\_\_\_  
With \_\_\_\_\_

Casing and Tubing	Used in Drilling	Left in Well	Packers
Size			Kind of Packer
16			
13			
10	<u>20'</u>	<u>20'</u>	Size of
8 1/4	<u>530'</u>	<u>Pulled</u>	<u>all</u>
6 1/2	<u>1638'</u>	<u>1638'</u>	Depth set <u>all</u>
5 3/16			
3			Perf. top
2			Perf. bottom
Liners Used			Perf. top
			Perf. bottom

Open Flow \_\_\_\_\_ /10ths Water in \_\_\_\_\_ Inch  
\_\_\_\_\_ /10ths Merc. in \_\_\_\_\_ Inch  
Volume \_\_\_\_\_ Cu. Ft.  
Rock Pressure \_\_\_\_\_ lbs. \_\_\_\_\_ hrs.  
Oil 428 bbls., 1st 24 hrs.  
Fresh water \_\_\_\_\_ feet \_\_\_\_\_ feet  
Salt water \_\_\_\_\_ feet \_\_\_\_\_ feet

CASING CEMENTED \_\_\_\_\_ SIZE \_\_\_\_\_ No. Ft. \_\_\_\_\_ Date \_\_\_\_\_  
COAL WAS ENCOUNTERED AT 190 FEET 24 INCHES  
340 FEET 48" INCHES FEET INCHES  
FEET INCHES FEET INCHES

Formation	Color	Hard or Soft	Top	Bottom	Oil, Gas or Water	Depth Found	Remarks
Yellow Clay				60			
Line Shells			60	120			
Sand			120	190			
Coal			190	192			
Slate			192	225			
Sand			225	340			
Coal			340	344			
Sandy Lime			344	395			
Slate			395	415			
Sand			415	530			
Black Slate			530	580			
Sand			580	660			
Line & Sand Shell			660	740			
Slate			740	790			
Hard Lime			790	820			
Slate			820	850			
Slate & Lime Shell			850	930			
Salt Sand			930	1415			
Slate			1415	1425			
Red Rock			1425	1445			
Line Shells & Slate			1445	1470			
Sandy Shells			1470	1520			
Maxon Sand			1520	1565			
Slate			1565	1570			
Little Lime			1570	1595			
Slate			1595	1600			
Lime			1600	1615			
Slate			1615	1632			
Pencil Cave			1632	1635			
Big Lime			1635	1795	Gas	1665'	Little
Slate			1795	1800			
Red Rock			1800	1815			
Sandy Lime			1815	1855	Oil & Gas	1855'	
Oil Sand			1855	1880			
Total Depth:				1880'			

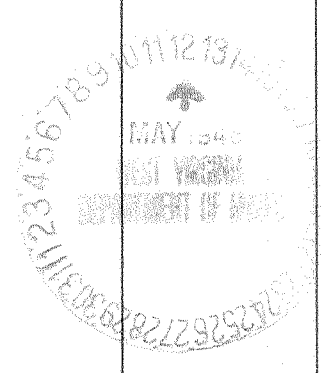

Formation	Color	Hard or Soft	Top	Bottom	Oil, Gas or Water	Depth Found	Remarks

Date May 11, 19 48

APPROVED VIRGINIAN GASOLINE & OIL COMPANY, Owner

By G. H. Moore  
 Chief Engineer (Title) R

