

Company VIRGINIAN GASOLINE & OIL CO.
 Address CHARLESTON, W. VA.
 Farm JACOB F. THUMM HEIRS
 Tract _____ Acres 60 Lease No. 27194
 Well (Farm) No. _____ Serial No. 2808
 Elevation (Spirit Level) 775'
 Quadrangle CLENDENIN
 County KANAWHA District ELK
 Engineer [Signature]
 Engineer's Registration No. 662
 File No. 70-63 Drawing No. _____
 Date JUNE 10, 1948 Scale 1" = 400'

STATE OF WEST VIRGINIA
 DEPARTMENT OF MINES
 OIL AND GAS DIVISION
 CHARLESTON

WELL LOCATION MAP
 FILE NO. KAN-506-A

+ Denotes location of well on United States
 Topographic Maps, scale 1 to 62,500, lat-
 itude and longitude lines being represented
 by border lines as shown.

- Denotes one inch spaces on border line
 of original tracing.

LAC... IMPERIAL TRACING CLOTH... VIRGINIAN GASOLINE & OIL CO., - KAN-506-A



STATE OF WEST VIRGINIA
DEPARTMENT OF MINES
OIL AND GAS DIVISION

1310

WELL RECORD

Oil or Gas Well Oil
(KIND)

Permit No. _____

Abandonment


Company VIRGINIAN GASOLINE & OIL COMPANY
Address P.O. Box 1273, Charleston 25, W. Va.
Farm Thumm Hrs. Acres 60
Location (waters) Elk River
Well No. 2808 Elev. 775
District Elk County Kanawha
The surface of tract is owned in fee by _____
Address _____
Mineral rights are owned by Geo. W. Thumm, Agt.
Sharon, Address West Virginia
Drilling commenced 2-23-12
Drilling completed 3-26-12
Date Shot Not Given From _____ To _____
With _____

Casing and Tubing	Used in Drilling	Left in Well	Packers
Size			Kind of Packer
16			
13			
10	58'	58'	Size of <u>all</u>
8 1/4	480'	480'	<u>not</u>
6 5/8	1585'	1585'	Depth set <u>all</u>
5 3/16			
3			Perf. top
2			Perf. bottom
Liners Used			Perf. top
			Perf. bottom

Open Flow _____ /10ths Water in _____ Inch
_____ /10ths Merc. in _____ Inch
Volume _____ Cu. Ft.
Rock Pressure _____ lbs. _____ hrs.
Oil 15 bbls., 1st 24 hrs.
Fresh water _____ feet _____ feet
Salt water _____ feet _____ feet

CASING CEMENTED _____ SIZE _____ No. Ft. _____ Date _____
COAL WAS ENCOUNTERED AT _____ FEET _____ INCHES
_____ FEET _____ INCHES FEET _____ INCHES
_____ FEET _____ INCHES FEET _____ INCHES

Formation	Color	Hard or Soft	Top	Bottom	Oil, Gas or Water	Depth Found	Remarks
Slate			0	140			
Sand			140	215			
Slate			215	270			
Sand			270	315			
Slate			315	380			
Sand			380	410			
Slate <u>slate</u>			410	414			
Coal & Shells			414	450			
Slate			450	500			
Sand			500	520			
Slate			520	560			
Sand			560	720			
Slate			720	780			
Sand			780	840			
Slate			840	890			
Lime & Shells			890	900			
Salt Sand			900	1390			
Little Lime			1390	1565			
Pencil Cave			1565	1580			
Big Lime			1580	1700			
Sand			1700	1760			
Slate & Shells			1760	1780			
Black Sand			1780	1816			
Oil Sand			1816	1826			
Total Depth:				1845'			

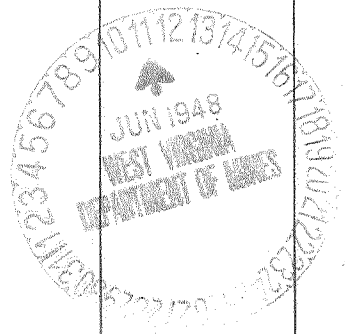

(Over)

SEP 23 1948

