


Latitude

39

38-35

Longitude 91° 20'

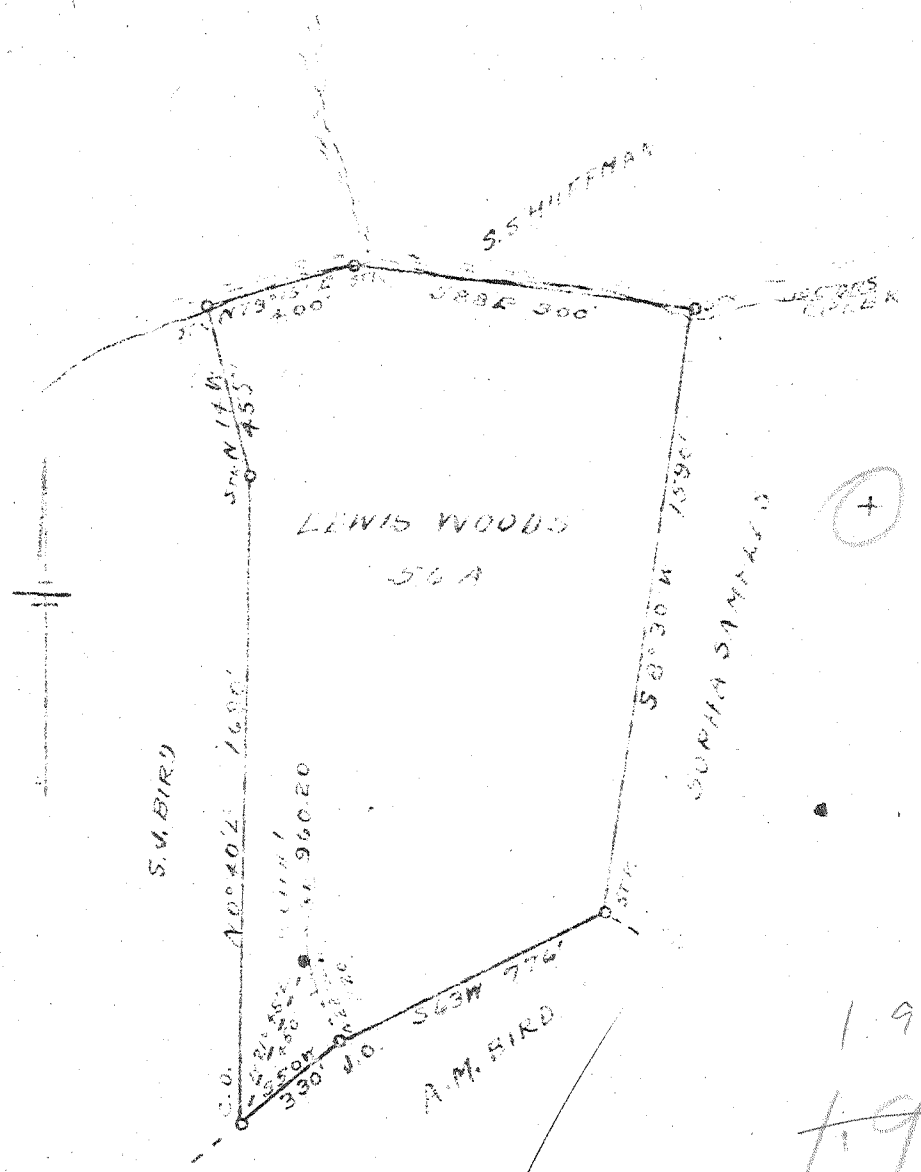

193
~~198 W~~
 5155

✓ AUG 31 1948

New Location
 Drill Deeper
 Abandonment

Company C. C. DODD
 Address SPENCER, W. VA.
 Farm LEWIS WOODS
 Tract _____ Acres 56 Lease No. _____
 Well (Farm) No. 1 Serial No. _____
 Elevation (Spirit Level) 960.20
 Quadrangle WALTON
 County KAYAWHA District BIG SANDY
 Engineer R. F. G...
 Engineer's Registration No. 804
 File No. _____ Drawing No. _____
 Date 3-10-48 Scale 1" = 500'

STATE OF WEST VIRGINIA
 DEPARTMENT OF MINES
 OIL AND GAS DIVISION
 CHARLESTON

WELL LOCATION MAP
 FILE NO. KAN-513-A

+ Denotes location of well on United States Topographic Maps, scale 1 to 62,500. latitude and longitude lines being represented by border lines as shown.

- Denotes one inch spaces on border line of original tracing.

LEWIS WOODS tr. 1 C. C. DODD KAN-513-A