

Company VIRGINIAN GASOLINE & OIL CO.  
 Address CHARLESTON, W. VA.  
 Farm J. M. YOUNG  
 Tract \_\_\_\_\_ Acres 150 Lease No. 603  
 Well (Farm) No. 9 Serial No. 2974  
 Elevation (Spirit Level) 744.5  
 Quadrangle CLENDENIN  
 County KANAWHA District BIG SANDY  
 Engineer [Signature]  
 Engineer's Registration No. 662  
 File No. 72-67 Drawing No. \_\_\_\_\_  
 Date AUGUST 31, 1948 Scale 1" = 400'

STATE OF WEST VIRGINIA  
 DEPARTMENT OF MINES  
 OIL AND GAS DIVISION  
 CHARLESTON

**WELL LOCATION MAP**  
 FILE NO. KAN-528-A

+ Denotes location of well on United States Topographic Maps, scale 1 to 62,500, latitude and longitude lines being represented by border lines as shown.

- Denotes one inch spaces on border line of original tracing.

"IMPERIAL" TRACING CLOTH  
 K & E CO., N. Y.

6-6 277

Big Sandy District, Kanawha County, W. Va.  
 By Virginian Gasoline & Oil Co., Box 1273, Charleston, 25, W. Va.  
~~Abandoned~~ Abandoned under permit Kan-.....-A?  
 On 150 acres, on Young Branch.  
 Elevation, 744.5' L.  
 Minerals owned by Julia Young et al., 6439 Hammel Ave., Cincinnati, Ohio.  
 Drilling commenced Aug. 27, 1912; completed Oct. 9, 1912.  
 Date of shot not given.  
 Oil, 350 bbls., Squaw Sand.  
 10" casing, 50'; 8 $\frac{1}{4}$ "", 636' (pulled); 6 $\frac{5}{8}$ "", 1551'.  
 Oil well. Abandonment reported to Dept. of Mines Sept. 1, 1948.  
 Record to RCT from Mrs. Griffith Jan. 5, 1949. Old File No. 1350.

	Top.	Bottom.
Slate	0	9
Salt Sand	948	1378
Red rock	1378	1390
Lime	1390	1440
Slate	1440	1447
Little Lime	1491	1520
Pencil Cave	1520	1530
Big Lime	1530	1666
Slate	166	1802
Oil sand (Squaw)	1802	1816
Total depth		1816



Completed no inspection

1350

STATE OF WEST VIRGINIA DEPARTMENT OF MINES OIL AND GAS DIVISION

WELL RECORD

Permit No. Ab 508-A

ABANDONMENT


Oil or Gas Well Oil (KIND)

Company VIRGINIAN GASOLINE & OIL CO.  
 Address P.O. Box 1273, Charleston 25, W. Va.  
 Farm J. M. Young Acres 150  
 Location (waters) Young Br.  
 Well No. 2974 Elev. 7445  
 District Big Sandy County Kanawha  
 The surface of tract is owned in fee by \_\_\_\_\_  
 Address \_\_\_\_\_  
 Mineral rights are owned by Julia Young et al  
6439 Hammel Ave. Address Cincinnati, Ohio  
 Drilling commenced 8-27-12  
 Drilling completed 10-9-12  
 Date Shot Not Given From \_\_\_\_\_ To \_\_\_\_\_  
 With Not Shown  
 Open Flow /10ths Water in \_\_\_\_\_ Inch  
 /10ths Merc. in \_\_\_\_\_ Inch  
 Volume \_\_\_\_\_ Cu. Ft.  
 Rock Pressure \_\_\_\_\_ lbs. \_\_\_\_\_ hrs.  
 Oil 350 (Squaw) bbls., 1st 24 hrs.  
 Fresh water \_\_\_\_\_ feet \_\_\_\_\_ feet  
 Salt water \_\_\_\_\_ feet \_\_\_\_\_ feet

Casing and Tubing	Used in Drilling	Left in Well	Packers
Size			
16			Kind of Packer
13			
10	50	50	Size of
8 1/4	636	Pulled	
6 5/8	1551	1551	Depth set
5 3/16			
3			Perf. top
2			Perf. bottom
Liners Used			Perf. top
			Perf. bottom

CASING CEMENTED	SIZE	No. Ft.	Date
COAL WAS ENCOUNTERED AT		FEET	INCHES
	FEET	INCHES	FEET
	FEET	INCHES	FEET

Formation	Color	Hard or Soft	Top	Bottom	Oil, Gas or Water	Depth Found	Remarks
Slate			0	9			
Salt Sand			948	1378			
Red Rock			1378	1390			
Lime			1390	1440			
Slate			1440	1447			
Little Lime			1491	1520			
Pencil Cave			1520	1530			
Big Lime			1530	1666			
Slate			1666	1802			
Oil Sand			1802	1816			
Total Depth				1816			

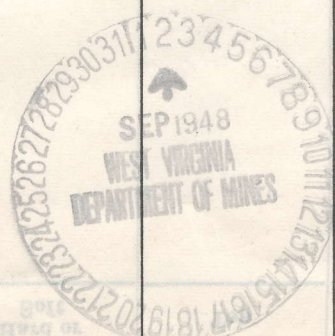

Handwritten circled 'C'

Formation	Color	Hard or Soft	Top	Bottom	Oil, Gas or Water	Depth Found	Remarks
			1805	1810			
			1800	1805			
			1830	1835			
			1820	1825			
			1815	1820			
			1810	1815			
			1805	1810			
			1838	1843			
			0	0			



DEPARTMENT OF MINES  
DIVISION OF OIL AND GAS

Date September 1, 1948

APPROVED VIRGINIAN GASOLINE & OIL CO., Owner

By G. H. Moore  
Chief Engineer (Title)