

New Location...   
 Drill Deeper.....   
 Abandonment.....

Company OKMULGEE SUPPLY CORP.  
 Address BOX 9111, OKMULGEE, OKLA.  
 Farm L.C. SLACK  
 Tract \_\_\_\_\_ Acres 57 Lease No. \_\_\_\_\_  
 Well (Farm) No. 31-2-3-4-5 Serial No. \_\_\_\_\_  
 Elevation (Spirit Level) SEE ABOVE  
 Quadrangle CLENDENNIN  
 County KANAWHA District ELK  
 Engineer L.H. Dye  
 Engineer's Registration No. 804  
 File No. \_\_\_\_\_ Drawing No. \_\_\_\_\_  
 Date 7-22-48 Scale 1" = 400'

STATE OF WEST VIRGINIA  
 DEPARTMENT OF MINES  
 OIL AND GAS DIVISION  
 CHARLESTON

**WELL LOCATION MAP**

KAN-527-A-#2  
 FILE NO. KAN-530-A-#3  
 KAN-536-A KAN-533-A-#4  
 #1 KAN-535-A-#5  
 + Denotes location of well on United States Topographic Maps, scale 1 to 62,500, latitude and longitude lines being represented by border lines as shown.  
 - Denotes one inch spaces on border line of original tracing.

60 217

L. C. SLACK NO. 4 WELL.

533A

Elk District, Kanawha County, W. Va.  
By Okmulgee Supply Corp., Box 911, Okmulgee, Okla.  
Abandoned under permit Kan-.....-A?  
On ..... acres.

Elevation, .....' L.  
Shot Nov. 25, 1912, at 1952-1962', May 15, 1914, at 2102-2110',  
July 30, 1920, at 1954-1960', and July 22, 1920, at 2103-2111'.  
8 5/8" casing, 510'; 7", 1706'; all left in.  
Oil well. Record to Dept. of mines stamped Sept. 8, 1948.  
Record to RCT from Mrs. Griffith Sept. 23, 1948. Old File No. 1311.

	Top.	Bottom.
Salt Sand	975	- 1546
Maxton Sand	1553	- 1638
Big Lime	1688	- 1835
Big Injun Sand	1835	- 1870
Squaw Sand	1952	- 1960
Weir Sand	2078	- 2112
Total depth		2118



*Completed No Inspection*

**1311**

STATE OF WEST VIRGINIA  
DEPARTMENT OF MINES  
OIL AND GAS DIVISION

**WELL RECORD**

Permit No. 533-A


Oil or Gas Well X (KIND)

Company OKMULGEE SUPPLY CORP.  
 Address Box 911 - Okmulgee, Okla.  
 Farm L. C. Slack Acres \_\_\_\_\_  
 Location (waters) \_\_\_\_\_  
 Well No. No. 4 Elev. \_\_\_\_\_  
 District Elk County Kanawha  
 The surface of tract is owned in fee by \_\_\_\_\_  
 Address \_\_\_\_\_  
 Mineral rights are owned by \_\_\_\_\_  
 Address \_\_\_\_\_  
 Drilling commenced \_\_\_\_\_  
 Drilling completed \_\_\_\_\_  
 Date Shot 11-25-12 From 1952 To 1962  
 With 5-16-14 2102 2110  
7-30-20 1954 1960  
 Open Flow 7-23-20 /10ths Water in 2103 2111 Inch  
 /10ths Merc. in \_\_\_\_\_ Inch  
 Volume \_\_\_\_\_ Cu. Ft.  
 Rock Pressure \_\_\_\_\_ lbs. \_\_\_\_\_ hrs.  
 Oil \_\_\_\_\_ bbls., 1st 24 hrs.  
 Fresh water \_\_\_\_\_ feet \_\_\_\_\_ feet  
 Salt water \_\_\_\_\_ feet \_\_\_\_\_ feet

Casing and Tubing	Used in Drilling	Left in Well	Packers
Size			Kind of Packer
16			
13			
10			Size of
8 1/8"	510'	510'	all
6 7/8"	1706'	1706'	Depth set all
5 3/16			
3			Perf. top
2			Perf. bottom
Liners Used			Perf. top
			Perf. bottom

CASING CEMENTED \_\_\_\_\_ SIZE \_\_\_\_\_ No. Ft. \_\_\_\_\_ Date \_\_\_\_\_  
 COAL WAS ENCOUNTERED AT \_\_\_\_\_ FEET \_\_\_\_\_ INCHES  
 \_\_\_\_\_ FEET \_\_\_\_\_ INCHES FEET \_\_\_\_\_ INCHES  
 \_\_\_\_\_ FEET \_\_\_\_\_ INCHES FEET \_\_\_\_\_ INCHES

Formation	Color	Hard or Soft	Top	Bottom	Oil, Gas or Water	Depth Found	Remarks
Salt Sand			975	1548			
Maxon Sand			1553	1638			
Big Lime			1688	1835			
Big Injun Sand			1835	1870			
Squaw Sand			1952	1960			
Weir Sand			2078	2112			
<b>Total Depth</b>				<b>2118</b>			

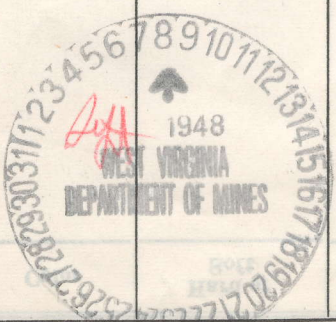

SEP 23 1948

